

FORM 51

Russell

KANSAS

Section 11 Township 14 Range 11WWell No. 1 BlehnCompany Elreco

0							

NORTH

WEST

EAST


SOUTH

5

Russell KANSAS

Sec. 11 Twp. 14 R. 14 WWell No. # 1 Blehn FarmElreco CompanyCarter Drlg. Contractor Ft. from N. Line350 Ft. from S. Line Ft. from E. Line350 Ft. from W. Line

SW SW NW (Twin well)

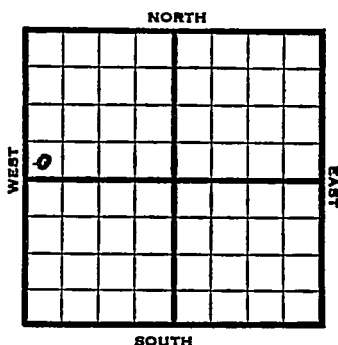

1952 Elev. 1850' REPORT

12/17 Spud 12-8-52
13" @ 450 10" @ 840

12/25 " " "

1/1 Drlg. 2230

1/8 Tarkio 2397 5" @ 2398 CO 2401 TD 550
7/2398-2401 open hole DD

1/22 NR

1/28 Spud 12-8-52
Oil Well
TD 2397
13" @ 450
10" @ 840
Tarkio 2389,
5" @ 2387
CO to 2397, SSO 7/2385-88,
dry, 36/2378-82, wtr.
CO TO 2397, 5 goph
PB 2394, Hydro 2 boph
Comp. 25 bopd

COMPLETED

County Russell State Kansas
 Sec. 11 (Blk. 14 (Sur. 14W Map No.
 (Twp.) (Rge.)
 Operator Elreco
 Well No. 1 Farm Elehn
 Elev. Location SWSW NW (twin well)

D							

350 Ft. From S Line NW

350 Ft. From W Line Quarter

1st. Report DEC 17 1952

Completion

Remarks

Carter Drlg. - Contr.

Spudding Date 12-8-52

Drlg. Data

13" @ 450 10" @ 840

County Russell State Kansas
 Sec. 11 (Blk. Twp.) 14 (Sur. Rge.) 14W Map No. _____
 Operator Elreco Ref.
 Well No. 1 Farm Blehn
 Elev. 1850 Location SW SW NW (twin well)

0							

350 Ft. From S Line NW

350 Ft. From W Line Quarter

1st. Report _____

Completion JAN 28 1953

Remarks _____

Carter Drlg. - Contr.

Spudding Date 12-8-52

Drlg. Data Oil well TD 2397

13" @ 450 10" @ 840 Tarkio 2389

5" @ 2387 CO to 2397 SSO 7/ 2385-88

dry 36/ 2378-82 wtr. CO to 2397 5 gop

PB 2394 Hydro. 2 boph

Comp. 25 bopd