

Sec. 8 Twp. 14 R. 12W

Section 8 Township 14 Range 12W

Well No. 1 M. Mahoney

Company W. M. Steinle

Well No. #1 M. Mahoney Farm

W. M. Steinle Company

Wildcat (Lewis Drlg., Cont.)


_____ Ft. from N. Line

330' Ft. from S. Line


_____ Ft. from E. Line

330' Ft. from W. Line

SE SW

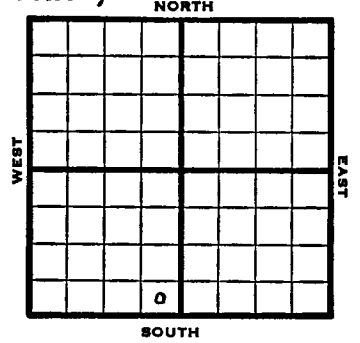

Wildcat
NORTH

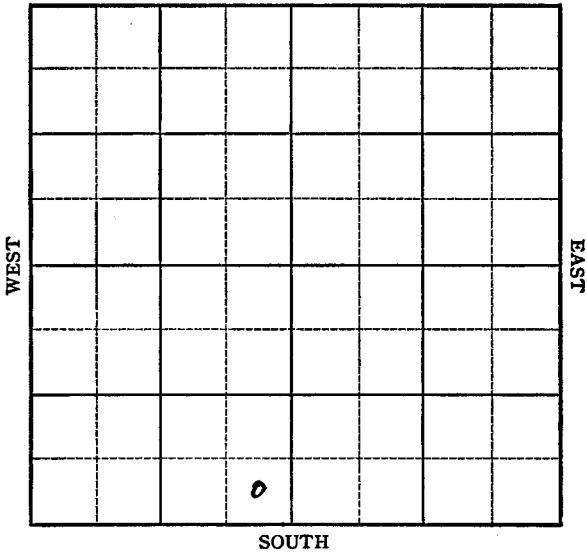

SOUTH

1949	Elev 1783'	REPORT
5/25	8" @ 150'	Anhy 700'
		Drlg. 865'
6/1	Lans 2926'	TD 2963'
	5" @ 2958'	
6/7	TD 2973'	wtr
6/15	"	
6/21	TD 2979'	4000 acid wtr.
		PB 2951
		2000 acid
		Wtr.
6/28	SD	
7/6	"	
7/12	"	
7/20	"	
7/27	"	
8/3	"	
8/10	"	
8/17	"	
8/24	"	
8/31	"	
9/7	"	
9/14	"	
9/21	"	
9/28	"	
10/5	"	

1949

10/12 SD
 10/19 "
 10/26 "
 11/1 "
 11/9 "
 1/16 "
 1/23 "
 1/29 "
 2/7 "
 2/14 "
 2/21 TD 2979'

Lansing 2926'
 Aband.

ABANDONED

Map No. _____ Sec. 5 Twp. 14 R. 12W

Well No. 1 M. Manoney

W. M. Steinle Company

Lewis Drlg. Contractor

SE SW

**FIRST REPORT
SECTION PLAT**

_____ Ft. from N. Line

330 Ft. from S. Line

_____ Ft. from E. Line

330 Ft. from W. Line

Russell County

Location _____

Rig up _____

Drilling and Remarks:

8" @ 150

Anhy 700

drlg. 865

RECORD

Cased _____ in, _____ ft.

Sand _____

Gas _____

Oil _____

Total Depth _____

PRODUCTION

1st 24 hrs. Nat. _____

1st 24 hrs. after shot _____

Gas _____ Cu. Ft.

Dry Hole _____

Abandoned _____

Date

MAY 25 1949

19

S. J. LEWIS

Scout

Map No. _____ Sec. 8 Twp. 14 R. 12W

Well No. 1 M. Mahoney

W. M. Steinle Company

ABANDONED Contractor

SE SW

E. 1783
SECTION PLAT

_____ Ft. from N. Line

330 Ft. from S. Line

_____ Ft. from E. Line

330 Ft. from W. Line

Russell County

Location _____

RECORD

Cased _____ in., _____ ft.

Sand _____

Gas _____

Oil _____

Total Depth 2528

PRODUCTION

1st 24 hrs. Nat. _____

1st 24 hrs. after shot _____

Gas _____ Cu. Ft.

Dry Hole _____

Abandoned _____

Date

DEC 21 1949 19

S. J. LEWIS Scout

Map No. K56 Sec. 8 Twp. 14 R. 12W

Well No. 1 M. Mahoney

W. M. Steinle Company

CORRECTION Contractor

SE SW

SECTION PLAT

_____ Ft. from N. Line

330 Ft. from S. Line

330 Ft. from E. Line

_____ Ft. from W. Line

Russell County

Location _____

RECORD

Cased _____ in., _____ ft.

Sand _____

Gas _____

Oil _____

Total Depth _____

PRODUCTION

1st 24 hrs. Nat. _____

1st 24 hrs. after shot _____

Gas _____ Cu. Ft.

Dry Hole _____

Abandoned _____

Date

JUN 1 1949 19

S. J. LEWIS Scout