


Section 9 Township 14 Range 12W
 Well No. 1 Mahoney
 Company Sam Kessler & Alex Schmidt

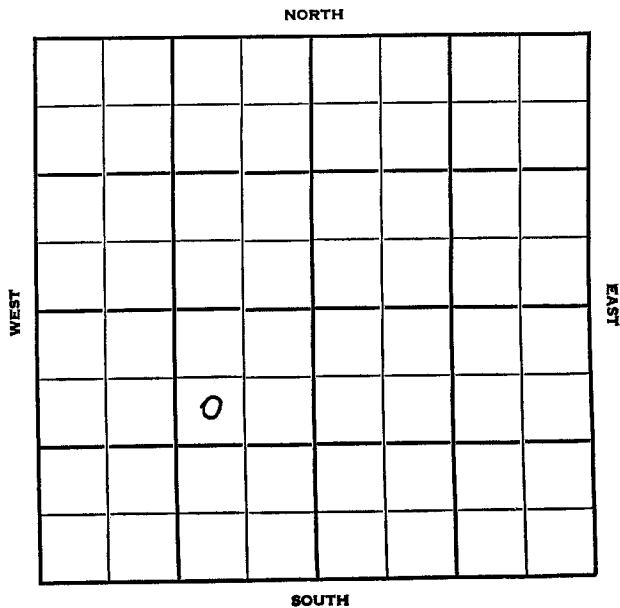

SEC. <u>9</u>	TWP. <u>14</u>	R. <u>12W</u> ✓
WELL NO. <u>1 Mahoney</u>		
COMPANY <u>Sam Kessler & Alex Schmidt</u> FARM		
CONTRACTOR <u>Duke & Wood</u>		


990 Wildcat from N. Line

_____ Ft. from S. Line

990 _____ Ft. from E. Line

_____ Ft. from W. Line

SW NE SW

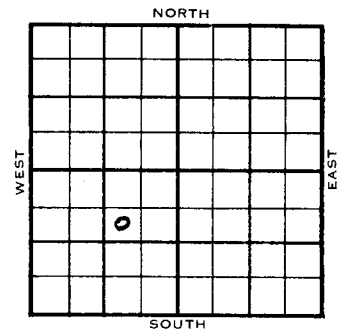

	ELEVATION	REPORT
1954	1830'	
7/7	Spudding 6-30-54 8" @ 241 Anhy 738 Drlg. 2640	
7/14	Spud 6-30-54 D & A TD 3352 8" @ 241 Anhy 738 Tario 2321 Lans. 2971 Arb. 3332 TD 3352 D & A	
	ABANDONED	

County	Russell		State	Kansas	
Sec.	9	(Blk. Twp.)	14	(Sur. Rge.)	12W Map No.
Operator	Sam Kessler & Alex Schmidt				
Well No.	1	Farm	Mahoney		
Elev.	1830	Location	SW NE SW		
			990 Ft. From	N Line	SW
			990 Ft. From	E Line	Quarter
			1st. Report		
			Completion JUL 14 1954		
			Remarks Wildcat		
			Duke & Wood - Contr.		
			Spudding Date 6-30-54		
Drig. Data	D & A		TD 3352		
8" @ 241			Anhy 738		Tarkio 2321
Lans. 2971			Arb. 3332		TD 3352
D & A					

J. G. McGEHEE