

Section 10 Township 14 Range 12 W

Well No. # 1 Bohnen

Company Lindsley Drlg.

SEC.	TWP.	R.
10	14	12 W



WELL NO. # 1 Bohnen FARM

COMPANY Lindsley Drlg.

CONTRACTOR Lindsley Wildcat

330 \_\_\_\_\_ Ft. from N. Line  
 \_\_\_\_\_ Ft. from S. Line  
 \_\_\_\_\_ Ft. from E. Line  
 330 \_\_\_\_\_ Ft. from W. Line

NW NW SW

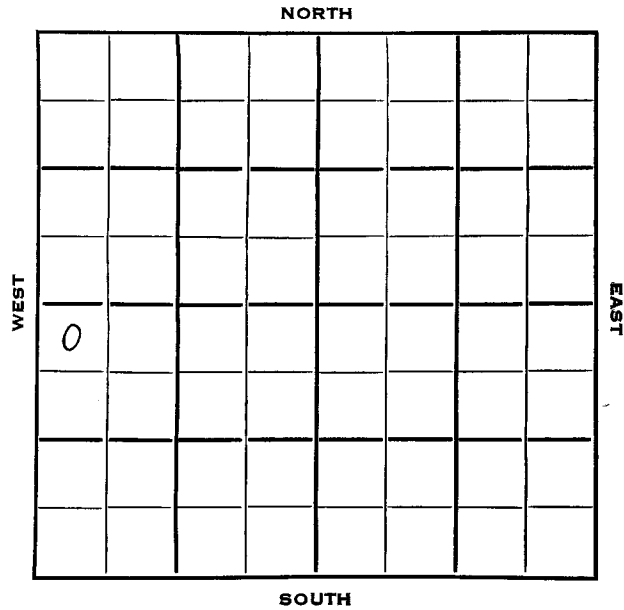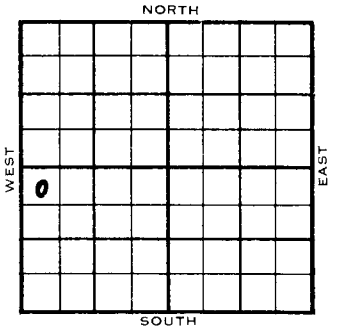

	ELEVATION	REPORT
1953	1835'	
12/2		Spud 11-26-53 Drlg. 1900'
12/9		8" @ 166 Tarkio 2328 Heeb 2895' Lans. 2976 DST 2981-3033, 1 hr, 250' SW 920#
12/16		Spud 11-26-53 D & A TD 3353 8" @ 166 Tarkio 2328 Heeb 2895' Lans. 2976 DST 2981-3033 open 1 hr rec 250' SW 920# SO 291-97 3010-31 Cong. 3324 Arb. 3342 TD 3353' D & A
		<b>ABANDONED</b>

