

15-167-21259

KANSAS DRILLERS LOG

API No. 15 — 167 — 21,259
County Number

Operator

Davies & Co., Inc.

Address

1304 Philtower Bldg. Tulsa, Okla 74103

Well No.

#1-13

Lease Name

Ben E. Major

Footage Location

1980

North
feet from (N) line

1980

West
feet from (W) line

Principal Contractor

B & B Drilling, Inc.

Geologist

J. R. Green

Spud Date

December 7, 1978

Total Depth

2345'

P.B.T.D.

Date Completed

December 13, 1978

Oil Purchaser


None (well was dry hole)

S. 13 T. 14 R. 12 K

Loc. SE NW

County Russell

640 Acres
N

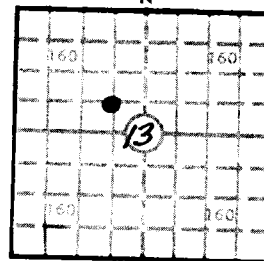

Locate well correctly

Elev.: Gr. 1736

DF 1738 KB 1741'

CASING RECORD

Report of all strings set — surface, intermediate, production, etc.

Purpose of string	Size hole drilled	Size casing set (in O.D.)	Weight lbs/ft.	Setting depth	Type cement	Sacks	Type and percent additives
Surface	12 1/4"	8-5/8"	28#	343'	Common	180	3%cc & 2% gel

LINER RECORD

Top, ft.	Bottom, ft.	Sacks cement
----------	-------------	--------------

PERFORATION RECORD

Shots per ft.	Size & type	Depth interval
---------------	-------------	----------------

TUBING RECORD

Size	Setting depth	Packer set at
------	---------------	---------------

ACID, FRACTURE, SHOT, CEMENT SQUEEZE RECORD

Amount and kind of material used	Depth interval treated

INITIAL PRODUCTION

Date of first production
WELL was Plugged as a DRY HOLE.

Producing method (flowing, pumping, gas lift, etc.)

RATE OF PRODUCTION
PER 24 HOURS

Oil

Gas

Water

Gas-oil ratio

bbls.

MCF


bbls.

CFPB

Disposition of gas (vented, used on lease or sold)

Producing interval (s)

INSTRUCTIONS: As provided in KCC Rule 82-2-125, within 90 days after completion of a well, one completed copy of this Drillers Log shall be transmitted to the State Geological Survey of Kansas, 4150 Monroe Street, Wichita, Kansas 67209. Copies of this form are available from the Conservation Division, State Corporation Commission, 3830 So. Meridian (P.O. Box 17027), Wichita, Kansas 66217. Phone AC 316-522-2206. If confidential custody is desired, please note Rule 82-2-125. Drillers Logs will be on open file in the Oil and Gas Division, State Geological Survey of Kansas, Lawrence, Kansas 66044.

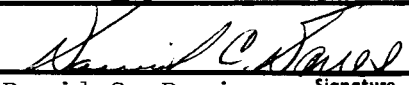Operator Davies & Company, Inc.		DESIGNATE TYPE OF COMP.: OIL, GAS, DRY HOLE, SWDW, ETC.:	
Well No. 1-13	Lease Name Ben E. MAJOR	DRY HOLE	
S <u>13</u> T <u>14</u> R <u>12</u> ^{XX} _W Center SE/4 NW/4			
WELL LOG		SHOW GEOLOGICAL MARKERS, LOGS RUN, OR OTHER DESCRIPTIVE INFORMATION.	
Show all important zones of porosity and contents thereof; cored intervals, and all drill-stem tests, including depth interval tested, cushion used, time tool open, flowing and shut-in pressures, and recoveries.			
FORMATION DESCRIPTION, CONTENTS, ETC.	TOP	BOTTOM	
Shale	0	593	
Anhydrite	593	628	
Shale	628	1525	
Lime and shale	1525	1555	
Shale	1555	1860	
Lime and shale	1860	2264	
Lime	2264	2345	
Rotary Total Depth	2345		
Dry Hole - Well was plugged.			
<u>DRILL STEM TESTS</u>			
#1 Ft. Riley Limestone <u>1503 - 1555'</u>			1741K. B. Elevation FORMATION DEPTH Herrington 1387 Krider 1427 Winfield 1475 Towanda 1541 Ft. Riley 1581 Cottonwood 1889 Grand Haven 2190 Tarkio 2263 Elmont 2327 T. D. 2345
#2 1st & 2nd Tarkio Sands <u>2195 - 2264'</u>			
#3 Tarkio Sands (3rd Tarkio) <u>2268 - 2325'</u>			
USE ADDITIONAL SHEETS, IF NECESSARY, TO COMPLETE WELL RECORD.			
Date Received	 _____ David C. Davies Signature President _____ Title February 1, 1979 _____ Date		