

RUSSELL

KANSAS


SECTION 14 TOWNSHIP 14 RANGE 12W

CORRECTION

WELL NO. #2 Mohoney

COMPANY Advance Drlg.

NORTH ~~SW NE NE~~ SE/4 SW NE SE

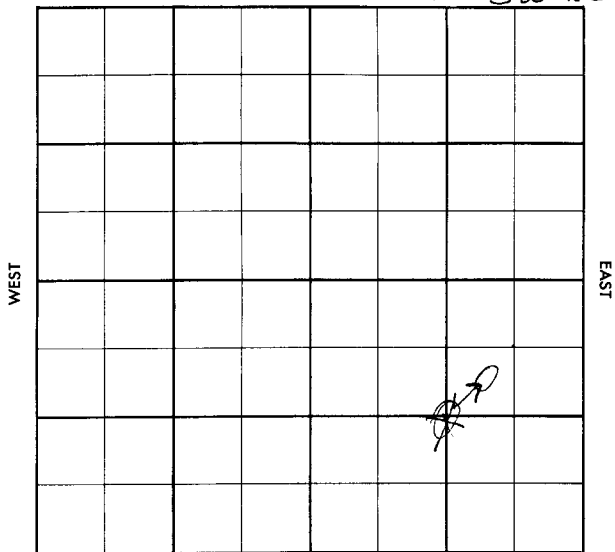

SOUTH

FORM 513 SUNRAY

County Russell Elev. 1734 DF
 Sec. 11 Twp. 14 Rge. 12W
 Company Advance Drlg.
 Farm Name Mohoney No. 2

TOPS	DEPTH	LOG	D. IN	Loc. in Sec.
Anh	592			SE/4 SW NE SE
Tp. <u>FTR</u>	1532			
H.				
Tr.				
Dg.				
Bl.				
L.				
K.C.				Geol.
B.K.C.				Contr.
Ce.				Co. tools
C.				Tool
M.				Wildcat
M.				COMPLETE APR 17 '57
K.				
Mz.				
Mo.				
V.				
S.				
S.				
A.				
R.				
PC.				
G.				
TD.				

Date Comm.

R U R FEB 27 '57 2-21-57 10 5/8
 362 7" @ 592 @ 605 MAR 6 '57
 @ 1480 MAR 13 '57 TD 1541 4 1/4"
 1530/50 est 100 MCF Not
 MAR 20 '57 CO DD 1590 RB 1541
 @ 9a 100 MCFG TO REACID
 MAR 27 '57 @ 9a 500 MCFG
 S.L. APR 10 '57 APR 17 '57 RP 400#
 9a 500 MCFG Pd.

~~WILDCAT~~

ORM 513 SUNRAY

County Russell Elev. _____
Sec. 14 Twp. 14 Rge. 12W
Company Advance Drlg.
Farm Name Mohoney No. 2

TOPS	DEPTH	LOG	DATUM	Loc. in Sec.
Ank				C SE/4
Ip				
H.				
Tr.				
Dg.				
Bl.				
L.				Geol. _____
K.C.				Contr. _____
B.K.C.				Co. tools _____
Ce.				
C.				
M.				
M.				Part _____
K.				<u>Wildcat</u>
Mr.				
Me.				
V.				
S.				
A				
R.				
PE.				
G.				
TD.				

FIRST REPORT
FEB 20 57

Site Comm. RUR

13