



Section 14 Township 14 Range 12W
 Well No. 1 Mahoney
 Company Advance Drlg.

SEC. 14 TWP. 14 R. 12 W
 WELL NO. # 1 Mahoney FARM
 COMPANY Advance Drlg.
 CONTRACTOR Co. tools

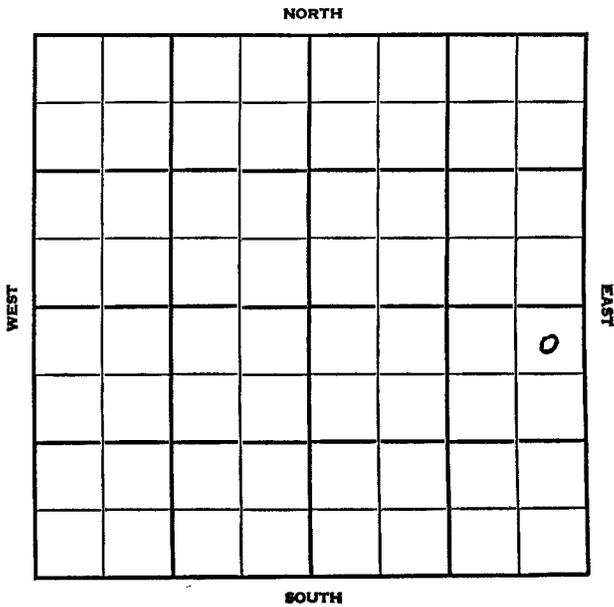

330 _____ Ft. from N. Line
 _____ Ft. from S. Line
 330 _____ Ft. from E. Line
 _____ Ft. from W. Line

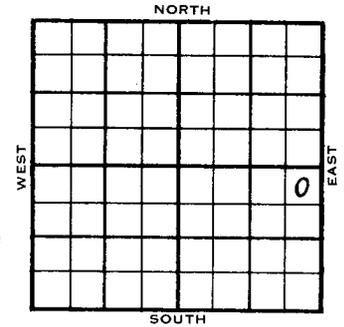

NE NE SE

	ELEVATION	REPORT
1955	1726'	
1/5	Spud 11-26-54	
	15" @ 55'	12" @ 365' 10" @ 580'
	Anhy 585'	8" @ 1885' 7" @ 2400'
	Heeb 2769'	KC 2866' 5" @ 2897'
	SG 1525-30	HFW 2890'
	Drlg. 3130'	
1/19	Spud 11-26-54	
	D & A	
	TD 3225'	
	15" @ 55'	
	12" @ 365'	
	10" @ 580'	
	Anhy 585'	
	8" @ 1885'	
	7" @ 2400'	
	Heeb 2769'	KC 2866'
	5" @ 2897'	
	SG 1525-30	HFW 2890' Cong 3169'
	TD 3225'	
	D & A	
		ABANDONED

