

Ind



SIDE ONE

P

STATE CORPORATION COMMISSION OF KANSAS
OIL & GAS CONSERVATION DIVISION

WELL COMPLETION OR RECOMPLETION FORM
ACO-1 WELL HISTORY

DESCRIPTION OF WELL AND LEASE

Operator: License # 5184
Name Shields Oil Producers, Inc.
Address Shields Bldg.
City/State/Zip Russell, Kansas 67665

Purchaser Mobil Oil Corp.
Box 900 Dallas, TX 75221

Operator Contact Person M. L. Ratts
Phone 913-483-3141

Contractor: License # 5655
Name Shields Drlg. Co., Inc.

Wellsite Geologist Francis Whisler
Phone 913-483-3020

Designate Type of Completion

- New Well
- Re-Entry
- Workover
- Oil
- Gas
- Dry
- SWD
- Inj
- Other (Core, Water Supply etc.)
- Temp Abd
- Delayed Comp.

If OWNO: old well info as follows:

Operator
Well Name
Comp. Date Old Total Depth

WELL HISTORY

Drilling Method:

- Mud Rotary
- Air Rotary
- Cable

5-11-85 5-19-85 6-19-85
Spud Date Date Reached TD Completion Date

3305
Total Depth PBTD

Amount of Surface Pipe Set and Cemented at 697 feet
Multiple Stage Cementing Collar Used? Yes No
if yes, show depth set feet
if alternate 2 completion, cement circulated from feet depth to w/ SX cmt

API NO. 15-167-22,607

County Russell

C... N/2 N/2 Sec. 15 Twp. 14 Rge. 12 East West

4620 Ft North from Southeast Corner of Section
2640 Ft West from Southeast Corner of Section
(Note: Locate well in section plat below)


Lease Name Beisel "A" Well # 9

Field Name Beisel

Producing Formation Arbuckle

Elevation: Ground 1810 KB 1815

Section Plat

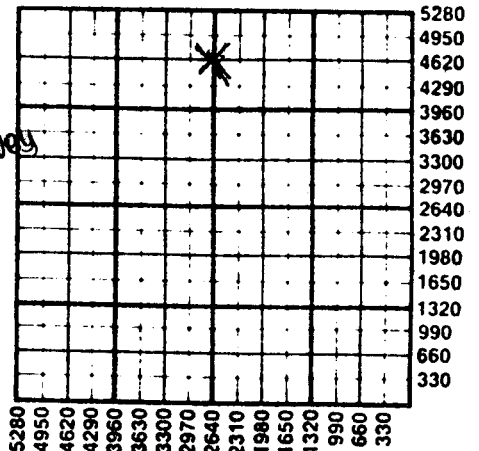

JUN 25 1985
State Geological Survey
WICHITA BRANCH

WATER SUPPLY INFORMATION

Disposition of Produced Water: Disposal Repressuring
Docket # D-23,757

Questions on this portion of the ACO-1 call:
Water Resources Board (913) 296-3717

Source of Water:
Division of Water Resources Permit # Not Applicable

Groundwater... Ft North from Southeast Corner (Well) ... Ft West from Southeast Corner of Sec Twp Rge East West

Surface Water... Ft North from Southeast Corner (Stream, pond etc) ... Ft West from Southeast Corner Sec Twp Rge East West

Other (explain) Farm Pond (purchased from city, R.W.D. #)

INSTRUCTIONS: This form shall be completed in duplicate and filed with the Kansas Corporation Commission, 200 Colorado Derby Building, Wichita, Kansas 67202, within 90 days after completion or recompletion of any well. Rule 82-3-130 and 82-3-107 apply.
Information on side two of this form will be held confidential for a period of 12 months if requested in writing and submitted with the form. See rule 82-3-107 for confidentiality in excess of 12 months.
One copy of all wireline logs and drillers time log shall be attached with this form. Submit CP-4 form with all plugged wells. Submit CP-111 form with all temporarily abandoned wells.

SIDE TWO

Operator Name Shields Oil Producers, Inc. Lease Name Beisel "A" Well # 9

Sec. 15 Twp. 14 Rge. 12 East West County Russell

WELL LOG

INSTRUCTIONS: Show important tops and base of formations penetrated. Detail all cores. Report all drill stem tests giving interval tested, time tool open and closed, flowing and shut-in pressures, whether shut-in pressure reached static level, hydrostatic pressures, bottom hole temperature, fluid recovery, and flow rates if gas to surface during test. Attach extra sheet if more space is needed. Attach copy of log.

Drill Stem Tests Taken Yes No
 Samples Sent to Geological Survey Yes No
 Cores Taken Yes No

Formation Description
 Log Sample

D.S.T. #1 2938'-2950' Times: 30-45-30-45 Rec. 90' M.W. w/scum of oil. I.H.P. - 1521#; I.F.P. - 52# to 52#; I.S.I.P. - 841#; F.F.P. - 74# to 74#; F.S.I.P. - 820# F.H.P. - 1521#.

D.S.T. #2 2953'-2970' Times: 5-45-45-45 Rec. 60' Gsy Mud w/s.o., 120' Gsy Mud, 60' Gsy Mdy Wtr and 240' Gsy Wtr. I.H.P. - 1557#; I.F.P. - 74# to 84#; I.S.I.P. - 789#; F.F.P. - 116# to 243#; F.S.I.P. - 768#; F.H.P. - 1552#.

D.S.T. #3 2997-3045 Times: 30-45 Rec 45' Mud. I.H.P. 1646#; I.F.P. - 75# to 107#; I.S.I.P. - 547

D.S.T. #4 3094'-3130' Times: 30-45-30-45 Rec 5' Mdy Oil and 55' SOCMW. I.H.P. - 1646#; I.F.P. - 42# to 42#; I.S.I.P. - 632#; F.F.P. - 53# to 53#; F.S.I.P. 600#; F.H.P. - 1636

Name	Top	Bottom
Anhydrite	687	724
Topeka Lm	2599	2839
Heebner Sh	2839	2841
Toronto Lm	2858	2872
Douglas Sh	2872	2921
L-K.C. Lm	2921	3198
Conglomerate	3260	3295
Arbuckle Dol	3295	RTD

(See extra page)

CASING RECORD <input type="checkbox"/> New <input type="checkbox"/> Used							
Report all strings set-conductor, surface, intermediate, production, etc.							
Purpose of String	Size Hole Drilled	Size Casing Set (In O.D.)	Weight Lbs/Ft.	Setting Depth	Type of Cement	#Sacks Used	Type and Percent Additives
Surface	12 1/4	8 5/8	24	697	Quickset	350	
Production	8 7/8	5 1/2	14	3300	Common	100	
PERFORATION RECORD				Acid, Fracture, Shot, Cement Squeeze Record			
Shots Per Foot	Specify Footage of Each Interval Perforated			(Amount and Kind of Material Used)		Depth	
	None			250 gal 15%		3305	
TUBING RECORD							
Size	Set At	Packer at	Liner Run	<input type="checkbox"/> Yes <input checked="" type="checkbox"/> No			
2 1/2	3302	None					