

Section **16** Township **14** Range **12W**


Sec. **16** Twp. **14** R. **12W**

Well No. **1 Bado**


Well No. **#1 Bado** Farm

Company **E. Berry Investment**

E. Berry Investment Company
Hall-Gurney (B & R Drlg., Cont.)

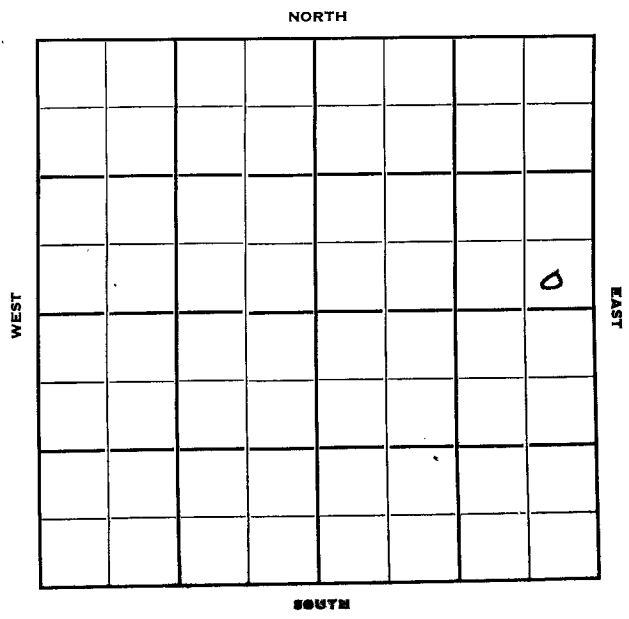

_____ Ft. from N. Line
330' Ft. from S. Line
330' Ft. from E. Line
 _____ Ft. from W. Line

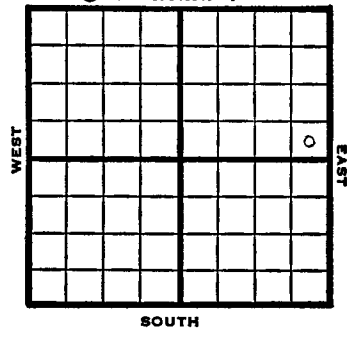

SE NE

1949	Elev 1759'	REPORT
10/19	8" @ 219'	Drlg. 1480'
10/26		Drlg. 3015'
11/1		"
11/9		"
11/16	TD 3290'	Lansing 2885'
		ong 3289'
		Aband.
		ABANDONED

Map No. _____ Sec. 16 Twp. 14 R. 12W

Map No. _____ Sec. 16 Twp. 14 R. 12W

Well No. 1 Bade

Well No. 1 Bade

E. Berry Investment Company

E. Berry Investment Company

ABANDONED Contractor

B & R Drlg. Contractor

SE NE

E11259
SECTION PLAT

SE NE

FIRST REPORT
SECTION PLAT

_____ Ft. from N. Line
330 Ft. from S. Line
330 Ft. from E. Line
_____ Ft. from W. Line

_____ Ft. from N. Line
330 Ft. from S. Line
330 Ft. from E. Line
_____ Ft. from W. Line

Russell County

Russell County

Location _____

RECORD

Rig up _____

Cased _____ in., _____ ft.

Drilling and Remarks:

Sand _____

Gas _____

Oil _____

Total Depth 3290

PRODUCTION

1st 24 hrs. Nat. _____

1st 24 hrs. after shot _____

Gas _____ Cu. Ft.

Dry Hole _____

Abandoned _____

Liams 2585
Comp 3289

Location _____

RECORD

Rig up _____

Cased _____ in., _____ ft.

Drilling and Remarks:

Sand _____

Gas _____

Oil _____

Total Depth _____

PRODUCTION

1st 24 hrs. Nat. _____

1st 24 hrs. after shot _____

Gas _____ Cu. Ft.

Dry Hole _____

Abandoned _____

8" @ 219
drlg. 1480

Date

NOV 16 1949 19 S. J. LEWIS Scout

Date

OCT 19 1949 19 S. J. LEWIS Scout