

KANSAS

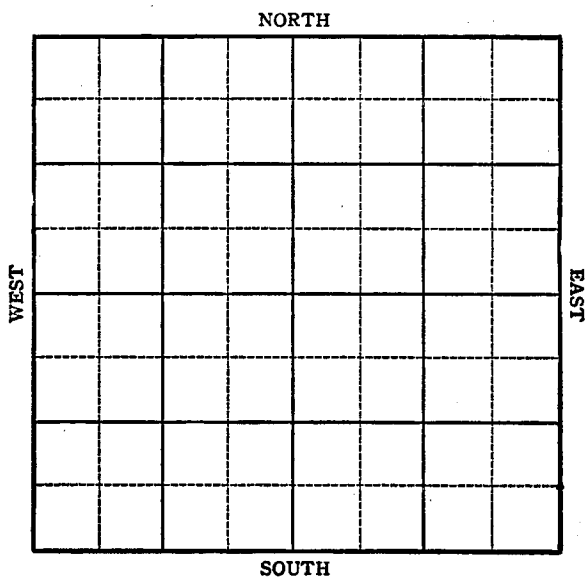
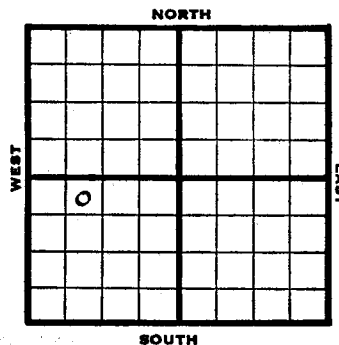
Russell

FORM 51 5M BR1X

Section 15 Township 14 Range 12WWell No. #1, Besiel "C"Company BridgeportFORM 252-A
5M 3-44 PETROL

KANSAS

Russell

Sec. 15 Twp. 14 R. 12WWell No. #1 Besiel "C" FarmBridgeport Company330 Ft. from N. Line Ft. from S. Line Ft. from E. Line990 Ft. from W. Line

1944

REPORT

6/7

Rotary

6/15

8" @ 250
Drlg. 1160

6/21

Lans 2922
Drlg. 3208

6/28

Cong 3219
Arb 3261-75 TD
Sat 5" @ 3265 RUST

7/12

Arb 3261
5" @ 3265
Water
TD 3314~~ABANDONED~~

ABANDONED

Pool Name Hall-GurneyMap No. 56 Sec. 15 Twp. 14 R. 12WWell No. 1 Besiel "C"

Bridgeport _____ Company

FIRST REPORT _____ Contractor

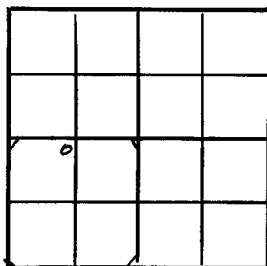
NE NW SW

SECTION PLAT

330 Ft. from N. Line

_____ Ft. from S. Line

_____ Ft. from E. Line

990 Ft. from W. Line

Russell County

Location _____

Rig up _____

Drilling and Remarks:
Rotary

RECORD

Cased _____ in, _____ ft.

Sand _____

Gas _____

Oil _____

Total Depth _____

PRODUCTION

1st 24 hrs. Nat. _____

1st 24 hrs. after shot _____

Gas _____ Cu. Ft.

Dry Hole _____

Abandoned _____

Date

JUN 7 1944 19 _____ S. J. LEWIS Scout

Pool Name WildcatMap No. 56 Sec. 15 Twp. 14 R. 12WWell No. 1 Besiel "C"

Bridgeport _____ Company

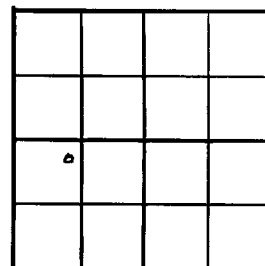
~~COMPLETED~~ _____ ContractorNE NW SW Abandoned

SECTION PLAT

330 Ft. from N. Line

_____ Ft. from S. Line

_____ Ft. from E. Line

990 Ft. from W. Line

Russell County

Location _____

Rig up _____

Drilling and Remarks:

CR 832615" 03265Water

RECORD

Cased _____ in, _____ ft.

Sand _____

Gas _____

Oil _____

Total Depth 237 1/4

PRODUCTION

1st 24 hrs. Nat. _____

1st 24 hrs. after shot _____

Gas _____ Cu. Ft.

Dry Hole _____

Abandoned 337 1/4

Date

JUL 1 2 1944 19 _____ S. J. LEWIS Scout