

Section 29 Township 14 Range 12W

Well No. #1 Ehrlich

Company R. E. Schmidt Lewis Mai

Sec. 20 Twp. 14 R. 12W

Well No. #1 Ehrlich Farm

Lewis Mai
~~R. E. Schmidt~~ Company

Schmidt Contractor
Hall-Gurney Pool

Ft. from N. Line

330 150



Ft. from S. Line

Ft. from E. Line

330 700

Ft. from W. Line

SW SW SW
SE

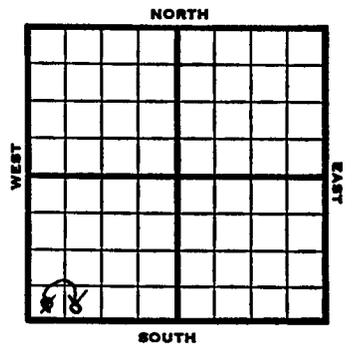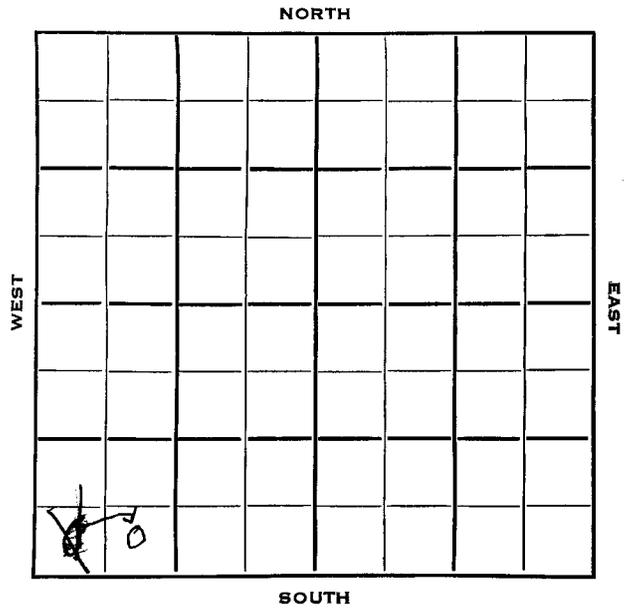

1953 Elev. 1685' REPORT

7/8 Spud 5-26-53
 15" @ 120
 12" @ 400
 10" @ 600
 Anhy 600, Tarkio 2190, sho wtr only
 8" @ 2240
 TD 2245, cleaning out

7/22 Top 2490' Lans 2833
 Drlg. 2903'

7/29 NR

8/19 TD 3038' 7" @ 3004'

8/26 N.R.

9/9 Spud 5-26-53
 D&A
 TD 3180
 15" @ 120
 12" @ 400
 10" @ 600
 Anhy 600, Tarkio 2190
 8" @ 2240
 TD 2245
 Top 2490, Lans 2833,
 TD 2995, DD 3006, 12 goph
 Cong 3145
 DD 3175, 7" @ 3084, CO to 3035
 24/2994-3000 wtr, B/1 bwph
 TD 3180 - D&A **ABANDONED**

Map No. _____ Sec. 20 Twp. 14 R. 12W

Well No. 1 Ehrlich


Lewis Mai Company

CORRECTION

Contractor

SE SW SW

SECTION PLAT

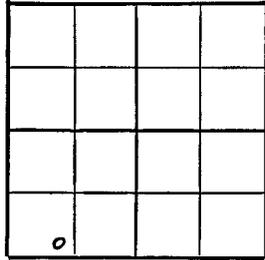

_____ Ft. from N. Line

150 Ft. from S. Line

_____ Ft. from E. Line

700 Ft. from W. Line

Russell County

Location _____

Rig up _____

Drilling and Remarks:

Reported

R. E. Schmidt

RECORD

Cased _____ in., _____ ft.

Sand _____

Gas _____

Oil _____

Total Depth _____

PRODUCTION

1st 24 hrs. Nat. _____

1st 24 hrs. after shot _____

Gas _____ Cu. Ft.

Dry Hole _____

Abandoned _____

Date

AUG 13 1953

19

J. G. McGFHEE

Scout

Map No. _____ Sec. 20 Twp. 14 R. 12W

Well No. 1 Ehrlich


R. E. Schmidt Company

Company

Contractor

SE SW SW

SECTION PLAT

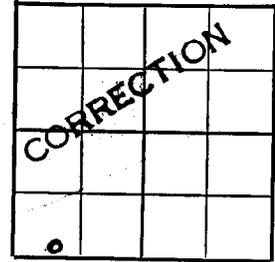

_____ Ft. from N. Line

150 Ft. from S. Line

_____ Ft. from E. Line

700 Ft. from W. Line

Location _____

Rig up _____

Drilling and Remarks:

Reported

SW SW SW

RECORD

Cased _____ in., _____ ft.

Sand _____

Gas _____

Oil _____

Total Depth _____

PRODUCTION

1st 24 hrs. Nat. _____

1st 24 hrs. after shot _____

Gas _____ Cu. Ft.

Dry Hole _____

Abandoned _____

Date

JUL 14 1953

19

J. G. McGFHEE

Scout

