

Section 20 Township 14 Range 12 W

Well No. # 1 Cross

Company Jones, Shelburne & Farmer

SEC.	20	TWP.	14	R.	12W
------	----	------	----	----	-----

WELL NO. #1 Cross

COMPANY Jones, Shelburne & Farmer FARM

CONTRACTOR J-S-F



Hall-Gurney Pool

_____ Ft. from N. Line

990 _____ Ft. from S. Line

_____ Ft. from E. Line

330 _____ Ft. from W. Line

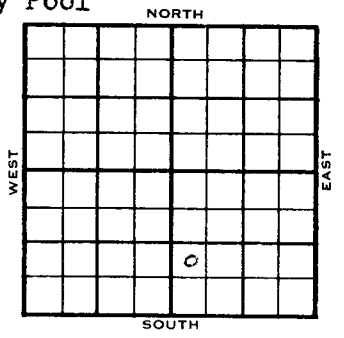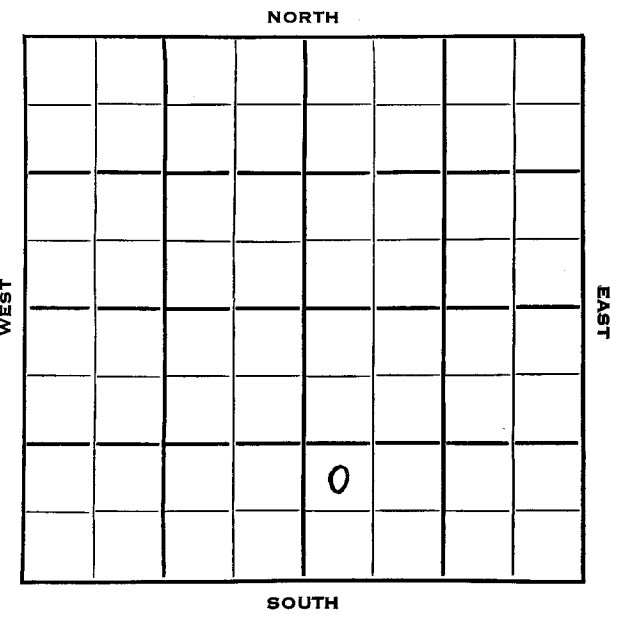

NW SW SE

1953	ELEVATION 1699'	REPORT
------	--------------------	--------

10/14 RUCT
 10/21 Drlg.
 10/28 Drlg. 1400'
 11/4 10" @ 610 8" @ 1969'
 11/11 Anhy 604' Tarkio 2204'
 Drlg. 2450'
 11/18 Drlg. 2785'
 1954
 1/6 Spud 10-14-53
 D & A TD 3015 12" @ 337
 10" @ 610 8" @ 1969 Anhy 604
 Tarkio 2204 Lans 2835'
 TD 2895 7" @ 2801 Whipstock 2835
 5" @ 2855 TD 3015'
 D & A

ABANDONED

