

Section 21 Township 14 Range 12W

Well No. 2 Teppe

Company Shelly-Millar


SEC.	TWP.	R.
21	14	12W

WELL NO. 2 Teppe FARM


COMPANY Shelly-Millar

CONTRACTOR Shelly-Millar

Heim Pool

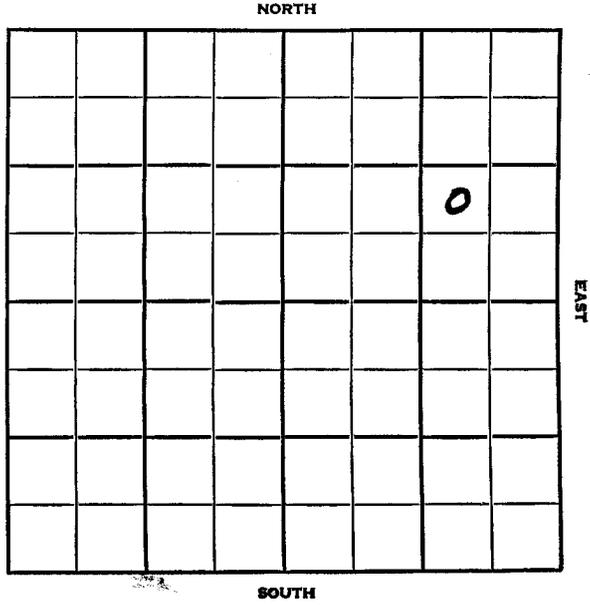

_____ Ft. from N. Line
990 _____ Ft. from S. Line
990 _____ Ft. from E. Line
 _____ Ft. from W. Line

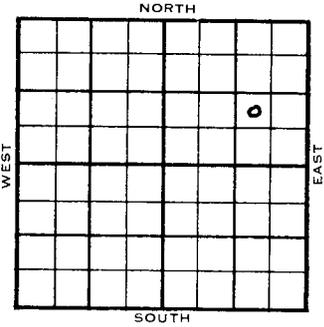

NW SE NE

1954	ELEVATION 1697'	REPORT
------	--------------------	--------

8/4 M I R
 9/1 Spud 8-2-54 SWD well TD 3390
 8" @ 175 Heeb 2739 Lans. 2822
 DST 3007-40 open 1 hr rec 35' wtry
 mud. 920# Cong. 3146
 DST 3146-66 open 1/2 hr red 6' mud Off
 DST 3156-86 open 1/2 hr rec 12' mud
 280# Arb. 3191 TD 3217 5" @ 3217
 DD 3390 CO to 3390 Comp. for SWD
 well. Input 2 BW per min.

ABANDONED

