

Section 22 21 Township 14 Range 12W

Well No. 1 Teppe


Company Shelly-Miller

SEC.	<u>21</u> <u>22</u>	TWP.	<u>14</u>	R.	<u>12W</u>
------	------------------------	------	-----------	----	------------

WELL NO. #1 Teppe FARM

COMPANY \_\_\_\_\_

CONTRACTOR Shelly-Miller

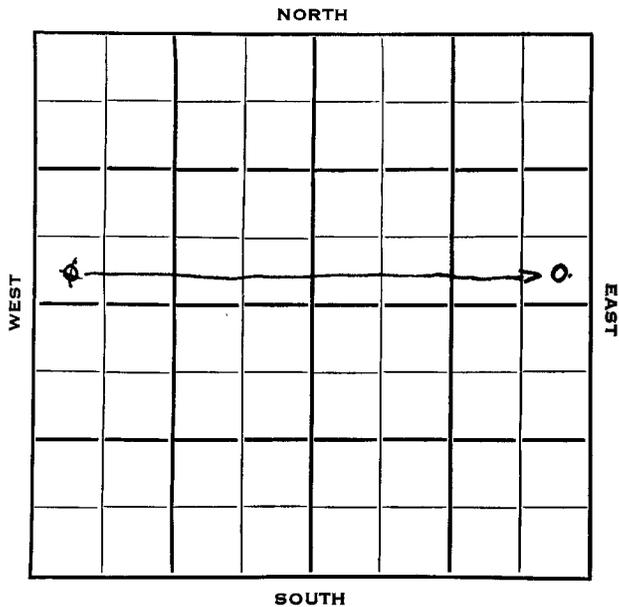

Shelly-Miller

Heim Pool


\_\_\_\_\_ Ft. from N. Line

330 \_\_\_\_\_ Ft. from S. Line

330 \_\_\_\_\_ Ft. from E. Line

330 \_\_\_\_\_ Ft. from W. Line

~~SE SW NE~~  
~~SW SW NW~~

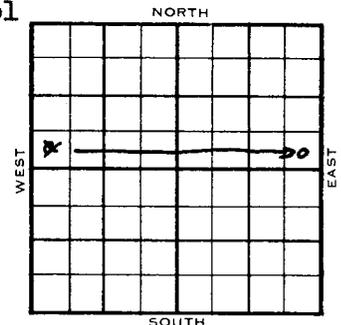

	ELEVATION	REPORT
1954	1741	

4/14 R U R

6/30 Spudding 4-12-54  
 Oil well  
 TD 3250  
 8" @ 185  
 Anhy 625 Heeb 2784 Lans. 2868  
 DST 2869-2915 open 1 hr. Rec. 62'wcm  
 825# Con  
 Cong. 3194  
 DST 3187 -3215 open 1 hr. Rec. 1080'  
 oil 750#  
 Arb. 3248  
 TD 3250  
 5" @ 3249  
 CO to 3218 24/ 3197-3205 s/ 13 bo  
 1 hr. Comp. 96 bopd

**COMPLETED**



Map No. \_\_\_\_\_ Sec. 21 Twp. 14 R. 12W

Well No. 1 Teppe

Shelly-Miller Company

CORRECTION Contractor

SE SE NE


SECTION PLAT

\_\_\_\_\_ Ft. from N. Line

330 Ft. from S. Line

330 Ft. from E. Line

\_\_\_\_\_ Ft. from W. Line

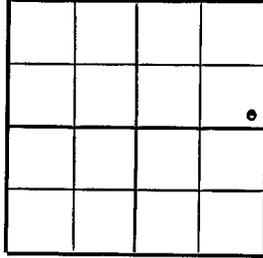

Russell County

Location \_\_\_\_\_

Rig up \_\_\_\_\_

Drilling and Remarks:

Reported

SW SW NW

22-14-12W

RECORD

Cased \_\_\_\_\_ in., \_\_\_\_\_ ft.

Sand \_\_\_\_\_

Gas \_\_\_\_\_

Oil \_\_\_\_\_

Total Depth \_\_\_\_\_

PRODUCTION

1st 24 hrs. Nat. \_\_\_\_\_

1st 24 hrs. after shot \_\_\_\_\_

Gas \_\_\_\_\_ Cu. Ft.

Dry Hole \_\_\_\_\_

Abandoned \_\_\_\_\_

Date

APR 21 1954 J. G. McGEE Scout