
DX 78-1 Russell KANSAS

Section 22 Township 14 Range 12W

Well No. #2 Miller

Company Lewis Mai

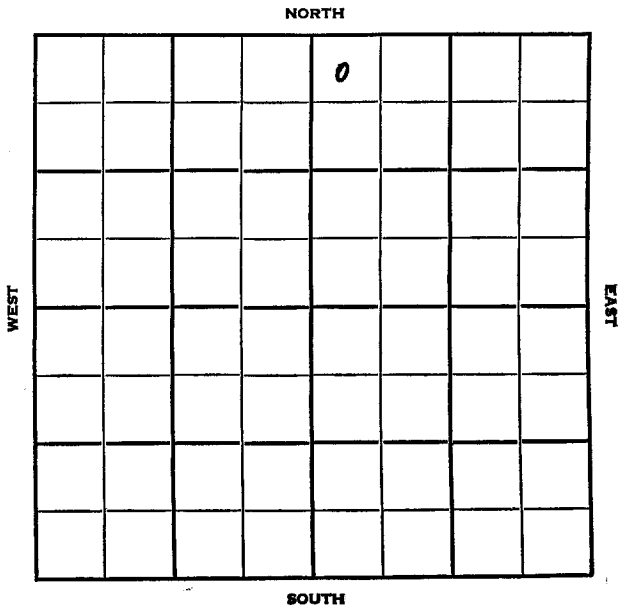

Russell KANSAS

SEC.	TWP.	R.
22	14	12W

WELL NO.

#2 Miller FARM

COMPANY

Lewis Mai

CONTRACTOR

Mast Drlg.


Heim Pool

330 Ft. from N. Line

Ft. from S. Line

Ft. from E. Line

330 Ft. from W. Line

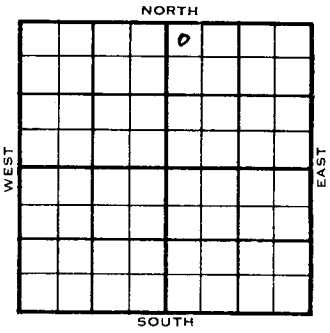

NW NW NE

Texas F/O

	ELEVATION 1764' REPORT
1954	
11/3	Spud 10-30-54 8" @ 191' Anhy 634' Drlg. 1430'
12/1	Spud 10-30-54 - D&A TD 3243' 8" @ 191' Anhy 634', Tarkio 2254', Lans 2892', Arb. 3238' TD 3243' 5" @ 3239' CO to TD 50A FU 60' oil 17 hrs., 500A s/ 15% oil 85% wtr. D&A

ABANDONED

DX-78

FORM 275 FOR SALE BY KANSAS BLUE PRINT CO.


County Russell State Kansas

Sec. 22 (Blk. Twp.) 14 (Sur. Rge.) 12W Map No.

Operator Lewis Mai

Well No. 2 Farm Miller

Elev. 1764 Location NW NW NE

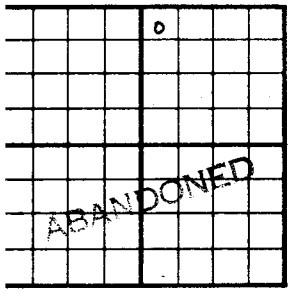

330 Ft. From N Line NE

330 Ft. From W Line Quarter

1st. Report

Completion DEC 1 19[illegible]

Remarks Heim Pool

Mast Drlg. - Contr.

Spudding Date 10-30-54

Drlg. Data D & A TD 3243

8" @ 191 Anhy 634 Tarkio 2254

Lans. 2892 Arb. 3238 TD 3243

5" @ 3239 CO to TD 50 A FU 60' oil

17 hr. 500 A S/ 15% oil 85% wtr.

D & A

FABEN GUSTRAP

FORM 275 FOR SALE BY KANSAS BLUE PRINT CO.


County Russell State Kansas

Sec. 22 (Blk. Twp.) 14 (Sur. Rge.) 12W Map No.

Operator Lewis Mai

Well No. 2 Farm Miller

Elev. Location NW NW NE

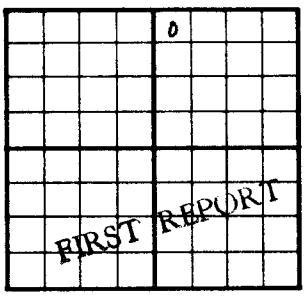

330 Ft. From N Line NE

330 Ft. From W Line Quarter

1st. Report NOV 3 195[illegible]

Completion

Remarks Texas farmout

Mast Drlg. - Contr.

Spudding Date 10-30-54

Drlg. Data Heim Pool

8" @ 191 Anhy 634 drlg. 1430

FABEN GUSTRAP