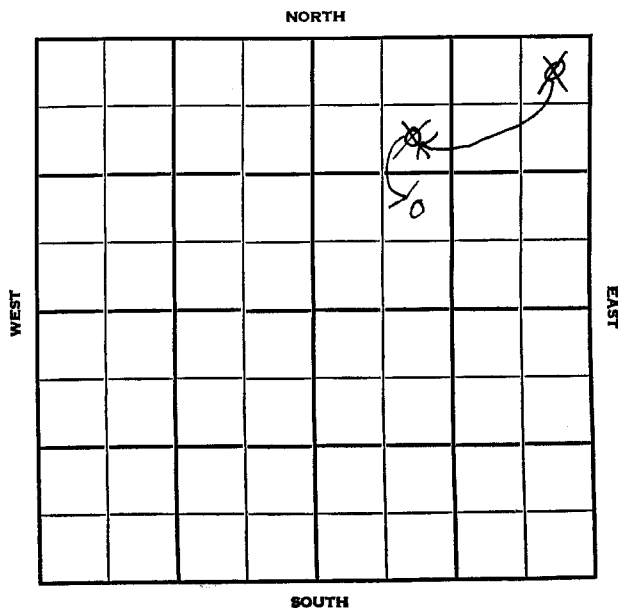


Section 22 Township 14 Range 12 WWell No. #3 MillerCompany Louis Mai

SEC.	TWP.	R.
22	14	12 W

WELL NO. # 3 Miller FARM

COMPANY

CONTRACTOR Louis Mai

Mast Drlg.

Hall-Gurney


990 Ft. from N. Line990 Ft. from S. Line

Ft. from E. Line

990 Ft. from W. Line

~~SE NW NE~~ NESW NE

~~NE NE NE~~

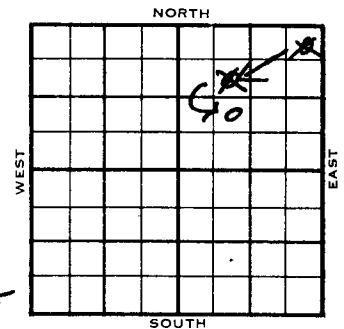

	ELEVATION	REPORT
1955	1746'	
8/24	RUR	
9/28	Comm 8-29-55 8 5/8" @ 240/125 DST 2883-96 Anh 618 H 2783 Tr 2802 KC 2870 KKC 3113 C 3184 A 3209 TD 3218 DST 2883-96 open 2 hr. 420' GIP Rec 6' ocm 55' mw 215/20" DST 2899- 2909 open 2 hr 570' GIP Rec 270' so & gcsw 765/20" 5 1/2" @ 3212/100 CO to 3218 500 A S/2.80 boph 12 hr. Comp 25 bopd	
		COMPLETED

QX-78

SCOUT TICKET

DX-201

SEC.	TWP.	R.
22	14	12W
WELL NO.		
3 Miller		
FARM		
COMPANY		
Louis Mai		
CONTRACTOR		

CORRECTION


SE NW NE

990 FT. FROM N. LINE

FT. FROM S. LINE

FT. FORM E. LINE

990 FT. FROM W. LINE

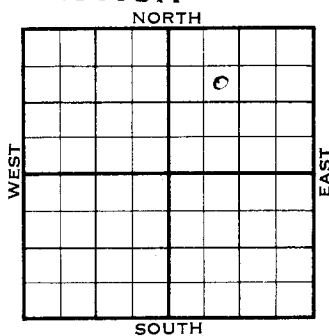

Russell County

☐ LOCATION	RECORD	CASED	IN.	FT.
☐ RIG UP		SAND		
DRILLING AND REMARKS:		GAS		
		OIL		
		TOTAL DEPTH		
Reported NE NE NE	PRODUCTION	1ST 24 HRS. NAT.		
		1ST 24 HRS. AFTER SHOT		
		GAS		CU. FT.
		DRY HOLE		
		ABANDONED		

DATE

AUG 31 1955

SCOUT

L. J. Harris

SCOUT TICKET

DX-201

SEC.	TWP.	R.
22	14	12W
WELL NO.		
3 Miller		
FARM		
COMPANY		
Louis Mai		
CONTRACTOR		


NE SW NE

FT. FROM N. LINE

990 FT. FROM S. LINE

FT. FORM E. LINE

990 FT. FROM W. LINE

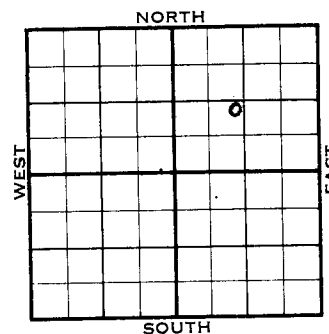

Russell County

☐ LOCATION	RECORD	CASED	IN.	FT.
☐ RIG UP		SAND		
DRILLING AND REMARKS:		GAS		
		OIL		
		TOTAL DEPTH		
Recorrected from SE NW NE	PRODUCTION	1ST 24 HRS. NAT.		
		1ST 24 HRS. AFTER SHOT		
		GAS		CU. FT.
		DRY HOLE		
		ABANDONED		

DATE

SCOUT

L. J. Harris
(JK)

County Russell Elev. 1746
 Sec. 22 Twp. 14 Rge. 12W
 Company Louis Mai
 FarmName Miller No. 3

TOPS	DEPTH	LOG	DATUM	Loc. in Sec.
Anb.	<u>618</u>			NE SW NE
Tr.				
H.	<u>2783</u>		<u>1039</u>	
Tr.	<u>2802</u>		<u>1054</u>	
Dg.				
BL.				
L.				
K.C.	<u>2870</u>		<u>1124</u>	Geol.
B.K.C.	<u>3113</u>		<u>1567</u>	Contr.
Ce.				Mast Drlg.
C.	<u>3184</u>		<u>1438</u>	
M.				
M.				Pool
K.				
Mz.				Hall-Gurney
Ma.				
V.				
S.				
S.				
A.	<u>209</u>		<u>1463</u>	
R.				
Pe.				
G.				
TD.	<u>3218</u>			

COMPLETE

Site Comm. 8-29-55 SEP 28 1955

8 5/8" @ 240/125 DST 2883-96

open 2 hr. 420' GIP Rec. 6' ocm

55' mw 215/20" DST 2899-2909 open

2 hr. 570' GIP Rec. 270' so & gcs

765/20" 5 1/2" @ 3212/100 CO to 3218

500 A S/ 2.80 boph 12 hr.

Comp. 25 bopd

County Russell Elev. 12W
 Sec. 22 Twp. 14 Rge. 12W
 Company Louis Mai
 FarmName Miller No. 3

TOPS	DEPTH	LOG	DATUM	Loc. in Sec.
Anb.				NE NE NE
Tr.				
H.				
Tr.				
Dg.				
BL.				
L.				
K.C.				Geol.
B.K.C.				Contr.
Ce.				Mast Drlg.
C.				
M.				
M.				Pool
K.				
Mz.				Hall-Gurney
Ma.				
V.				
S.				
S.				
A.				
R.				
Pe.				
G.				
TD.				

AUG 24 '55

FIRST REPORT

Date Comm.

RUR