

Section 22 Township 14 Range 12 W

Well No. #5 Teppe "B"

Company Shelly-Miller

SEC.	22	TWP.	14	R.	12W
------	----	------	----	----	-----

WELL NO. #5 Teppe "B" FARM

COMPANY Shelly-Miller

CONTRACTOR Co. Tools

Heim



_____ Ft. from N. Line

_____ Ft. from S. Line

_____ Ft. from E. Line

_____ Ft. from W. Line

SW SE NW

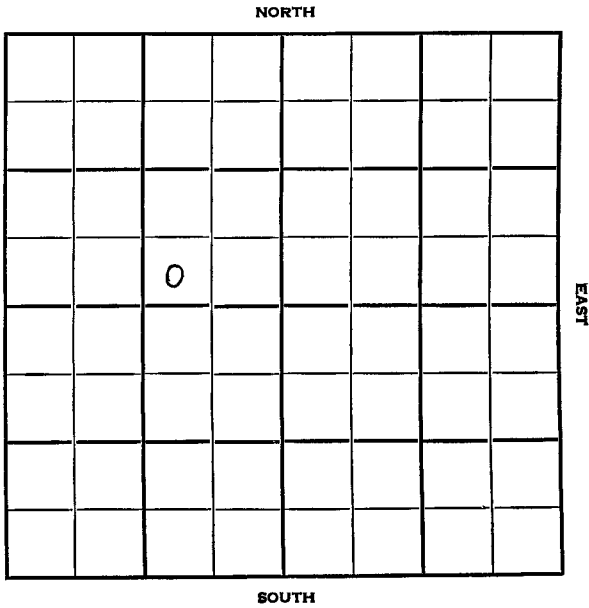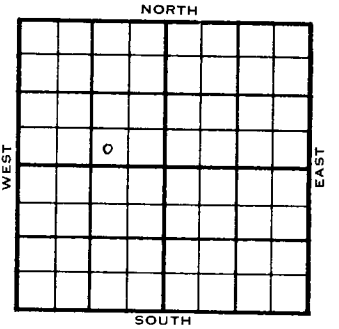

1955	ELEVATION 1793'	REPORT
------	--------------------	--------

7/27 M I M

8/17 8/3/55
 8 5/8" @209 w/135
 DST 2916-40 open 30" Rec 5' mud BHP 30
 DST 3231-54 open 30" Rec. 10' Mud BHP
 580, DST 3226-65 open 40" Rec. 20'
 Mud BHP 370 no log D&A
 H: 2825, 1032, L: 2914, 1121,
 C: 3231, 1438,

ABANDONED

County Russell Elev. 1793
 Sec. 22 Twp. 14S Rge. 12W
 Company Shelly-Miller
 FarmName Tepe "B" No. 5

TOPS	DEPTH	LOG	DATUM	Loc. in Sec.
Anh.				SW SE NW
Sp.				
H.	<u>2825</u>		<u>1032</u>	
Tr.				
Dg.				
Bl.				
L.	<u>2914</u>		<u>1121</u>	Geol.
K.C.				Contr.
B.K.C.				Co. tools
Ce.				Pool
C.	<u>3231</u>		<u>143B</u>	Heim
M.				
M.				
K.				
Mz.				
Me.				
V.				
S.				
S.				
A.				
R.				
Pe.				
G.				
TD.	<u>9280</u>			

AUG 17 1955
 ABANDONED

Date Comm. 8/3/55 8 5/8 209 w/135
 ST 2916-40 open 30" Rec. 5' Mud BHP 30
 ST 3231-54 open 30" Rec. 10' Mud BHP 580
 ST 3226-65 open 40" Rec. 20' Mud BHP 370
 no log
 D & A

County Russell Elev. 1793
 Sec. 22 Twp. 14 Rge. 12W
 Company Shelly-Miller
 FarmName Tepe "B" No. 5

TOPS	DEPTH	LOG	DATUM	Loc. in Sec.
Anh.				SW SE NW
Sp.				
H.				
Tr.				
Dg.				
Bl.				
L.				Geol.
K.C.				Contr.
B.K.C.				Co. tools
Ce.				Pool
C.				Heim
M.				
M.				
K.				
Mz.				
Me.				
V.				
S.				
S.				
A.				
R.				
Pe.				
G.				
TD.				

FIRST REPORT
 JUL 27 1955

Date Comm. W I M
