


Russell KANSAS

Section 22 Township 14 Range 12 W

Well No. # 1 Miller

Company Lewis Mai

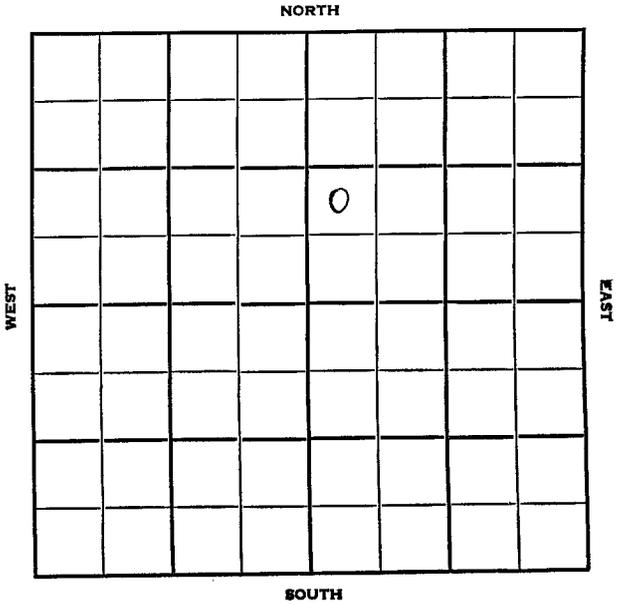

SEC.	22	TWP.	14	R.	12W
WELL NO.	#1 Miller				
COMPANY	Lewis Mai				
CONTRACTOR	Mast Tools				

Heim Pool

\_\_\_\_\_ Ft. from N. Line


990 \_\_\_\_\_ Ft. from S. Line

\_\_\_\_\_ Ft. from E. Line

330 \_\_\_\_\_ Ft. from W. Line

NW SW NE

Texas F/O

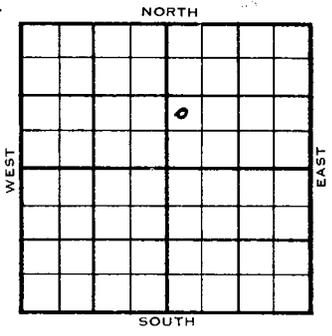

	ELEVATION	REPORT
1954	1769'	
9/15	Spud 9-10-54 8" @ 181' w/125 sks Anhy 642' Drlg. 1765'	
12/222	Spud 9-10-54 Oil Well TD 3243' 8" @ 181' Anhy 642' KC 2892' DST 2896'-2907' opn 1 hr, rec 1200' gas 60' vh ocm, 660# Arb. 3238' TD 3243' 5" @ 3239' CO to 3243' 500 A S/ 3 bo 8 hr. P/ 45 bopd. Comp 25 bopd. 3 to 5 % Wtr.	COMPLETED

