

Section 28 Township 14 Range 12 W

Sec. 28 Twp. 14 R. 12W


Well No. #1 Grove

Well No. #1 Grove Farm


Company Fred Haynes

Fred Haynes Company

Contractor Semi-Wildcat

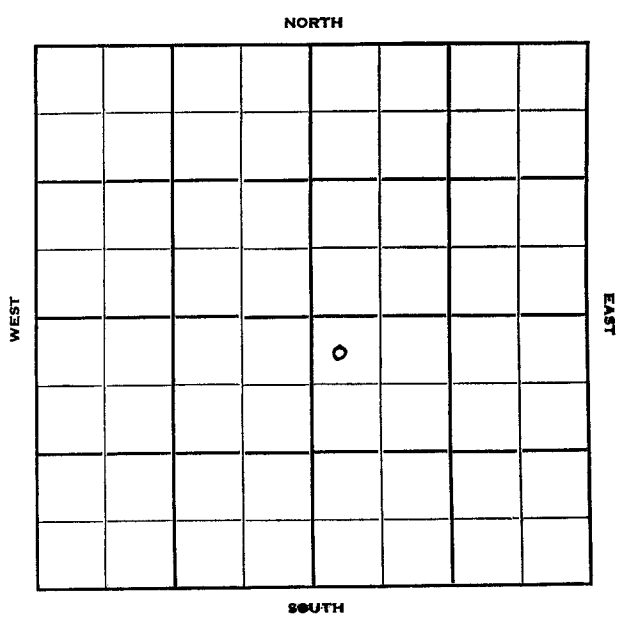

330' Ft. from N. Line  
 \_\_\_\_\_ Ft. from S. Line  
 \_\_\_\_\_ Ft. from E. Line  
 330' Ft. from W. Line  
 NW NW SE

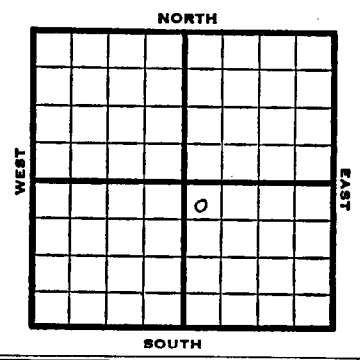

1951 Elev. 1692' REPORT	
1/17	Spud 1-4-51 10" @ 590' Anhy 590 Drlg. 1510'
2/14	Spud 1-4-51 D&A TD 3184' 10" @ 590' Anhy 590' Tarkio 2290' 8" @ 2260' KC 2870' 7" @ 2870' 5" @ 3096' Cong. 3155' Arb. 3170-84 TD D&A <b>ABANDONED</b>

