



FORM 51 Russell KANSAS  
 Section 28 Township 14 Range 12W  
 Well No. #1 Harbaugh  
 Company Stearns Petroleum Company

FORM 252-B Russell KANSAS ✓  
 Sec. 28 Twp. 14 R. 12W  
 Well No. #1 Harbaugh Farm  
 Stearns Petr. Company

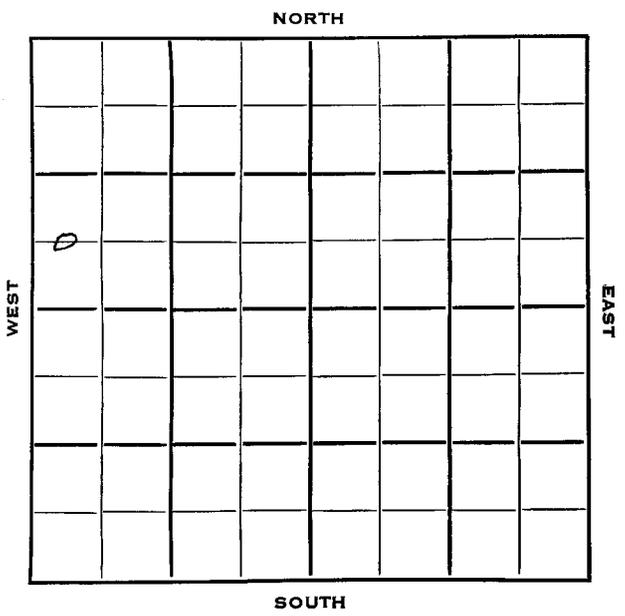

Lewis Pool Contractor  
 Ft. from N. Line 660  
 Ft. from S. Line  
 Ft. from E. Line  
 330 Ft. from W. Line  
 C W L SW NW

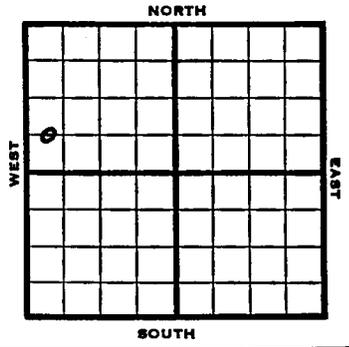

1953	Elev. 1656' REPORT
3/25	Location
4/2	8" @ 233 Anhy 572 Heeb 2717 Lans 2797 DST 2826-46, 1 hr, 30' OCM 105# DST 2888-2904, 1 hr, 90' wtry Mud & SSO 670# Drlg. 3000'
4/8	Spud 3-20-53 TD 3145' 8" @ 233 Anhy 572, Heeb 2717, Lans 2797, DST 2826-46 open 1 hr. Rec 30' ocm 105# DST 2888-2904 open 1 hr. Rec 90' wtr mud & SSO 670# Arb 3140, TD 3145' D & A
	<b>ABANDONED</b>

County **Russell** State **Kansas**

Sec. **28** (Blk. Twp.) **14** (Sur. Rge.) **12W** Map No.

Operator **Stearns Pet.**

Well No. **1** Farm **Harbaugh**

Elev. Location **C W L SW NW**


**660** Ft. From **S** Line **NW**

**330** Ft. From **W** Line **Quarter**

1st. Report **MAR 25 1953**

Completion

Remarks

Spudding Date

Drig. Data **Lewis Pool**

**Location**

J. G. McGENEE

County **Russell** State **Kansas**

Sec. **28** (Blk. Twp.) **14** (Sur. Rge.) **12W** Map No.

Operator **Stearns Pet.**

Well No. **1** Farm **Harbaugh**

Elev. **1656** Location **C W L SW NW**


**660** Ft. From **S** Line **NW**

**330** Ft. From **W** Line **Quarter**

1st. Report

Completion **APR 8 1953**

Remarks **Lewis Pool**

Spudding Date **3-20-53**

Drig. Data **D & A** **TD 3145**

**8" @ 233** Anhy **572** Heeb. **2717**

Lans. **2797** DST **2826-46** open **1 hr.**

Rec. **30' ocm** **105#** DST **2888-2904**

open **1 hr.** Rec. **90' wtry mud & SSO**

**670#** Arb. **3140** **TD 3145**

**D & A**

J. G. McGENEE