


Russell KANSAS

DX 78 O.W.W.O.

Section 28 Township 14 Range 12W
 Well No. 3 Harbaugh
 Company Duke & Wood

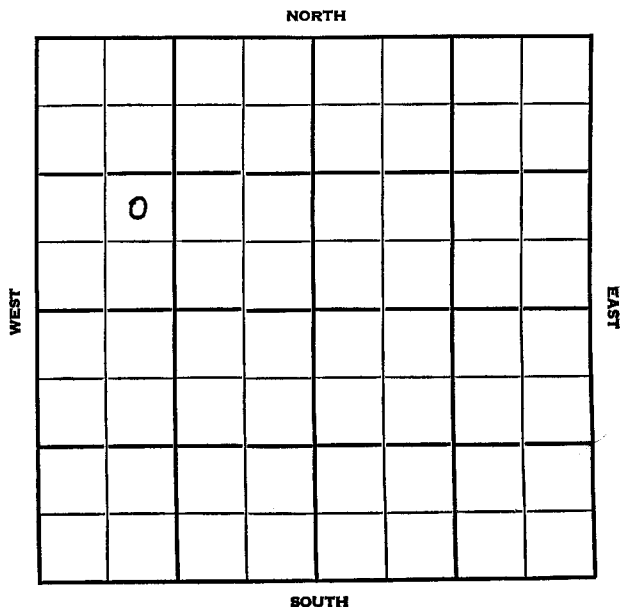

O.W.W.O. Russell KANSAS
 SEC. 28 TWP. 14 R. 12W
 WELL NO. 3 Harbaugh FARM
 COMPANY Duke & Wood
 CONTRACTOR

Co. tools

Hall Gurney


1000 - 1000 N. Line

990 Ft. from S. Line

Ft. from E. Line

990 Ft. from W. Line

NE SW NW

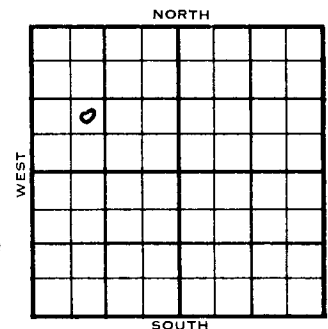

1954

ELEVATION

1653'

REPORT

7/21

Location

8/18

Spud 7-21-54

Oil Well

TD 2833'

8" @ 197'

Heeb 2711', Mans 2794'

DST 2799-2817', opn 1 hr., rec. 95' gas,

25' O&GCM, 75#

DST 2823-31', opn 1 hr., rec. 85' gas,

155' SO&GCM, 655#

TD 2831'

5" @ 2827'

DD 2833'

B/5 gw 2 go 6000A

Comp. 25 bopd 15 bw

COMPLETED

OVER

DX-78

O.W.W.O.

1955
1/5

Lans 2794'
 OTD 2833'
 5" @ 2827'
 DD @ 2963'

3/9

SWD Well
 TD 3127'
 Lans 2794'
 OTD 2833'
 5" @ 2827'
 DD 2963' DD 3010' DD 3112'
 Cong. 3097'
 TD 3127'
 Comp SWD Well.

ABANDONED

County	Russell		State	Kansas	
Sec.	28	(Blk. Twp.)	14	(Sur. Rge.)	12W Map No.
Operator	Duke & Wood				
Well No.	3	Farm	Harbaugh		
Elev.	1653	Location	NE SW NW		
			990 Ft. From S Line	NW	
			990 Ft. From W Line	Quarter	
			Ist. Report		
			Completion	MAR 9 1955	
Remarks	OWWO				
Spudding Date					
Drilg. Data	SWD well		TD 3127		
Lans. 2794 OTD 2833 5" @ 2827					
DD 2963 DD 3010 DD 3112 Cong. 3097					
TD 3127 Comp. SWD well					

FABEN GILSTRAP

O.W.W.O.

County	Russell	State	Kansas																																				
Sec.	28	(Bk. Twp.) 14	(Sur. Rge.) 12W Map No.																																				
Operator	Duke & Wood																																						
Well No.	3	Farm	Harbaugh																																				
Elev.	1653	Location	NE SW NW																																				
<table border="1"> <tr><td></td><td></td><td></td><td></td><td></td><td></td></tr> <tr><td></td><td></td><td></td><td></td><td></td><td></td></tr> <tr><td></td><td></td><td></td><td></td><td></td><td></td></tr> <tr><td></td><td></td><td></td><td></td><td></td><td></td></tr> <tr><td></td><td></td><td></td><td></td><td></td><td></td></tr> <tr><td></td><td></td><td></td><td></td><td></td><td></td></tr> </table>																																							
990 Ft. From S Line NW																																							
990 Ft. From W Line Quarter																																							
1st. Report																																							
Completion AUG 18 1954																																							
Remarks Hall-Gurney Pool																																							
Co. tools																																							
Spudding Date 7-21-54																																							
Drig. Data Oil well TD 2833																																							
8" @ 197 Heeb. 2711 Lans. 2794																																							
DST 2799-2817 open 1 hr. Rec. 95' gas																																							
25' o & gcm 75# DST 2823-31 open 1 hr.																																							
Rec. 85' gas 155' so & gcm 655#																																							
TD 2831 5" @ 2827 DD 2833																																							
B/ 5 gw 24go 6000 A																																							
Comp. 25 bopd 15 bw																																							

FABEN GILSTRAP

County	Russell	State	Kansas																																				
Sec.	28	(Bk. Twp.) 14	(Sur. Rge.) 12W Map No.																																				
Operator	Duke & Wood																																						
Well No.	3	Farm	Harbaugh																																				
Elev.	1653	Location	NE SW NW																																				
<table border="1"> <tr><td></td><td></td><td></td><td></td><td></td><td></td></tr> <tr><td></td><td></td><td></td><td></td><td></td><td></td></tr> <tr><td></td><td></td><td></td><td></td><td></td><td></td></tr> <tr><td></td><td></td><td></td><td></td><td></td><td></td></tr> <tr><td></td><td></td><td></td><td></td><td></td><td></td></tr> <tr><td></td><td></td><td></td><td></td><td></td><td></td></tr> </table>																																							
990 Ft. From S Line NW																																							
990 Ft. From W Line Quarter																																							
1st. Report JAN 5 1955																																							
Completion																																							
Remarks O.W.W.O.																																							
Spudding Date																																							
Drig. Data Hall-Gurney Pool																																							
Lans. 2794 OTD 2833 5" @ 2827																																							
DD @ 2963																																							

FABEN GILSTRAP

