

DX 78-1

SEC.	28	TWP.	14	R.	12W
------	----	------	----	----	-----

Section 28 Township 14 Range 12W

WELL NO. 2 Harbaugh FARM


Well No. 2 Harbaugh

COMPANY Duke & Wood

Company Duke & Wood

CONTRACTOR Duke & Wood

Hall-Gurney Pool

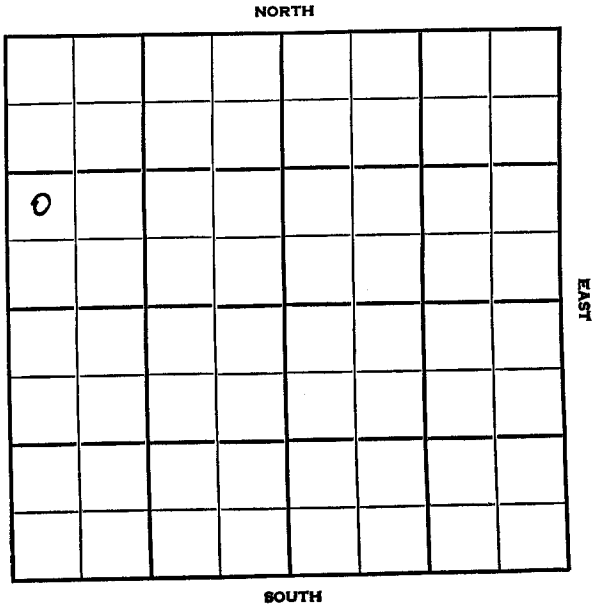


_____ Ft. from N. Line

990 _____ Ft. from S. Line

_____ Ft. from E. Line

330 _____ Ft. from W. Line

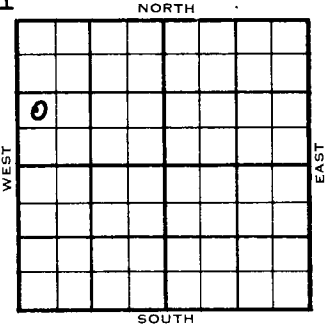

NW SW NW

	ELEVATION	REPORT
1954	1657'	
7/17 31/77		R U R
7/21		8" @ 203' Lans 2807' Drlg. 2845'
8/18		Spud 7-12-54 - Oil Well TD 2912' 8" @ 203' Lans 2807' DST 2814-30', opn 1 hr., rec. 120' mco, 60' oil, 710# TD 2899' 5" @ 2899' DD 2912', 50 gwph PB 2873' 55/2831-36, 600QA S/12 1/2 boph C omp. 60 bopd 40 bw COMPLETED

