

KANSAS Russell

5M 10-48 PETROL

Russell KANSAS

Sec. 29 Twp. 14 R. 12W ✓

Section 29 Township 14 Range 12W

Well No. 2 Ehrlich

Company El Capitan

Well No. #2 Ehrlich Farm

El Capitan Company

Hall-Gurney



330' Ft. from N. Line

990' Ft. from S. Line

330' Ft. from E. Line

660' Ft. from W. Line

~~C N L SW NW~~
NE NW

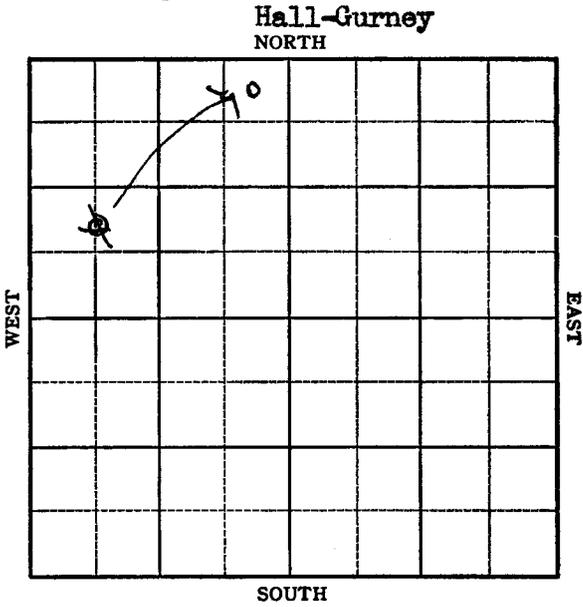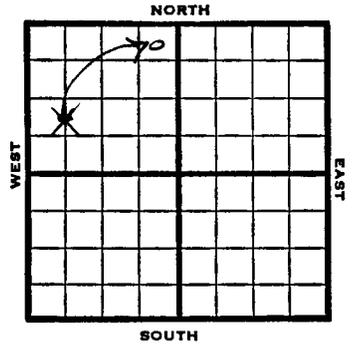

1949	Elev 1684'	REPORT
2/9		Location
2/16		"
2/23		"
3/2		"
3/8		"
3/16		D rlg 150
3/23		10" @ 300'
		Drig. 1775'
3/30		Lansing 2810'
		Drig 2906'
4/6		Arb. 3185-98'
		TD 3198
		5" @ 3198'
4/12		"
4/20		PB 3183'
		20 shots 3173-79
		500 acid
		SO &W
		PB 3129'
4/27		"
5/4		"
5/10		"
5/18		"
5/25		TD 3200'
		Arb. 3185'
		5" @ 3185'
		Aband.
ABANDONED		

Map No. K56 Sec. 29 Twp. 14 R. 12W

Well No. 2 Ehrlich

El Capitan Company

ABANDONED Contractor

NE NW

SECTION PLAT

	0		

330 Ft. from N. Line

_____ Ft. from S. Line

330 Ft. from E. Line

_____ Ft. from W. Line

Russell County

Location _____

Rig up _____

Drilling and Remarks:

2 8 3155
5" @ 183'

RECORD

Cased _____ in., _____ ft.

Sand _____

Gas _____

Oil _____

Total Depth 3200

PRODUCTION

1st 24 hrs. Nat. _____

1st 24 hrs. after shot _____

Gas _____ Cu. Ft.

Dry Hole _____

Abandoned _____

Date

MAY 25 1949 19

S. J. LEWIS Scout

Map No. 56 Sec. 29 Twp. 14 R. 12W

Well No. 2 Ehrlich

El Capitan Company

CORRECTION Contractor

NE NW

SECTION PLAT

	0		

330 Ft. from N. Line

_____ Ft. from S. Line

330 Ft. from E. Line

_____ Ft. from W. Line

Russell County

Location _____

Rig up _____

Drilling and Remarks:

Reported
C N L SW NW

RECORD

Cased _____ in., _____ ft.

Sand _____

Gas _____

Oil _____

Total Depth _____

PRODUCTION

1st 24 hrs. Nat. _____

1st 24 hrs. after shot _____

Gas _____ Cu. Ft.

Dry Hole _____

Abandoned _____

Date

MAR 30 1949 19

S. J. LEWIS Scout

Kansas

Hall Gurney

Map No. _____ Sec. 29 Twp. 14 R. 12 W

Well No. 2 Echalich

El Capitan Company

FIRST REPORT

Contractor

C N L S W N W

SECTION PLAT

_____ Ft. from N. Line

490 Ft. from S. Line

_____ Ft. from E. Line

660 Ft. from W. Line

3			

Russell

Location

Rig up _____

Drilling and Remarks:

RECORD

Cased _____ in., _____ ft.

Sand _____

Gas _____

Oil _____

Total Depth _____

PRODUCTION

1st 24 hrs. Nat. _____

1st 24 hrs. after shot _____

Gas _____ Cu. Ft.

Dry Hole _____

Abandoned _____

Date

FEB 9 1949 19 S. J. LEWIS Scout