

Russell


KANSAS

SECTION 29 TOWNSHIP 14S RANGE 12W

WELL NO. #4 Ehrlich

COMPANY Smoky Hill Petr. Co., Inc.

NORTH SE NW NW

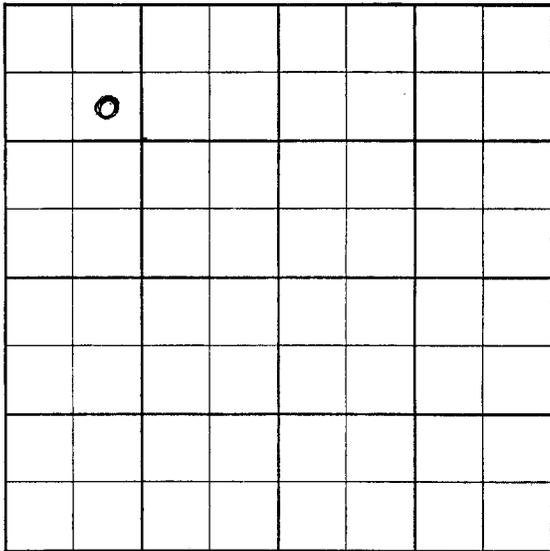

Top Pool
CORRECTION

8-513-8

County Russell Elev. _____
 Sec. 29 Twp. 14 Rge. 12W
 Company Smoky Hill Pet. Co., Inc.
 Well Name Ehrlich No. 4

| TOPS | DEPTH | LOG | DATUM |
|--------|-------|-----|-------|
| Aph. | 587 | | |
| Gravel | 2153 | | |
| H. 270 | 3188 | | |
| T. 3 | 3254 | | |
| Dg. | 3297 | | |
| B-L | 3737 | | |
| H. | 3755 | | |
| L.K.C. | 3818 | | |
| B.K.C. | | | |
| Ce. | 3110 | | |
| C. | | | |
| M. | | | |
| M. | | | |
| K. | | | |
| Mx. | | | |
| Mq. | | | |
| V. | | | |
| S. | | | |
| S. | | | |
| A. | | | |
| R. | | | |
| Pf. | | | |
| G. | | | |
| I.D. | 3/65 | | |

Loc. in Sec. SE NW NW
 Geol. _____
 Contr. Triangle
 Pool Hall-Gurney
 ABANDONED
 MAY 28 '58

Date Comm. 5-3-58
 Location APR 30 '58 MAY 7 '58 594/350
MAY 14 '58 Ø 27 90 MAY 21 '58 DST 2820-05
1hr 20'm 30 BHP 0/20" OST
2850-65 Ø 45" 6'M BHP 120/20"
DST 2910-20 Ø 30" 7'M SDR 5011
BHP 700/20" MAY 29 '58


D6A
D6A

~~Post~~ ~~13~~
~~Post~~ ~~13~~

i-513-B

County Russell Elev. _____
 Sec. 29 Twp. 14 Rge. 12W
 Company Smoky Hill Pet. Co., Inc.
 Farm Name Ehrlich No. 4

| TOPS | DEPTH | LOG | DATUM | Loc. in Sec. |
|--------|-------|-----|-------|--------------------|
| Anh. | | | | SE NW NW |
| Tp. | | | | |
| H. | | | | |
| Tr. | | | | |
| Dg. | | | | |
| B.L. | | | | |
| L. | | | | Geol. |
| K.C. | | | | |
| B.K.C. | | | | Contr. |
| Ce. | | | | <u>Triangle</u> |
| C. | | | | |
| M. | | | | Pool |
| M. | | | | <u>Hall-Gurney</u> |
| K. | | | | |
| Mz. | | | | |
| Mq. | | | | |
| V. | | | | |
| S. | | | | |
| S. | | | | |
| A. | | | | |
| R. | | | | |
| Pf. | | | | |
| G. | | | | |
| T.D. | | | | |

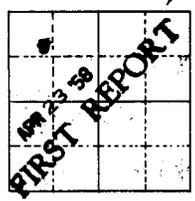

Date Comm. _____
 Location Location

Co
 Sec
 T
 R