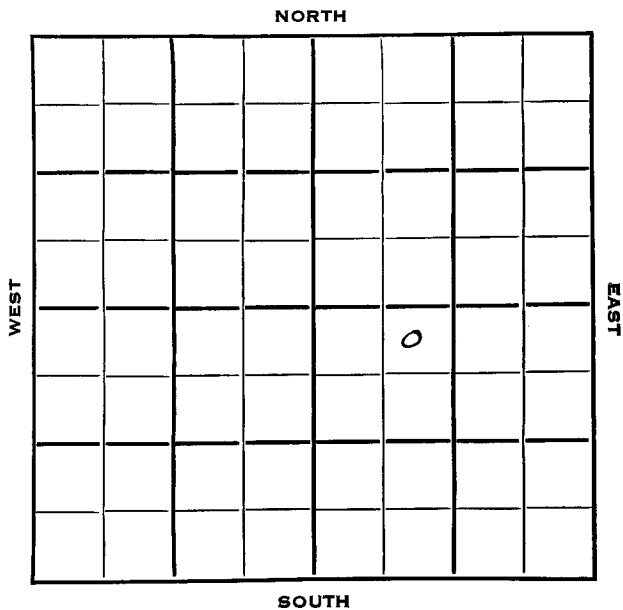


Russell

KANSAS

Section 29 Township 14 Range 12WWell No. #2 KepkaCompany Smokey Hill Oil

SEC. <u>29</u>	TWP. <u>14</u>	R. <u>12 W</u> ✓
WELL NO. <u># 2 Kepka</u>		
COMPANY <u>Smokey Hill Oil</u>		
CONTRACTOR <u>FARM</u>		

Hall-Gurney Pool


330 _____ Ft. from N. Line

_____ Ft. from S. Line

_____ Ft. from E. Line

990 _____ Ft. from W. Line

NE NW SE

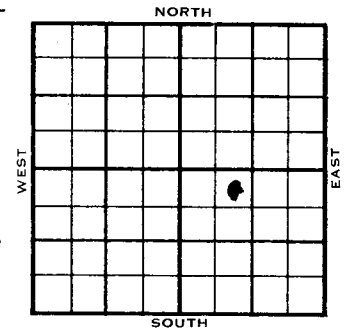

	ELEVATION	REPORT
1954	1687'	
1/6	MICT	
1/13	NR	
1/20	"	
1/27	10" @ 260 w/150 Anhy 611' Drlg. 1668'	
2/3	RTD 2905' 7" @ ?	
2/10	7" @ 2905'	
2/24	Spud 1-24-54 Oil Well TD 2905' 10" @ 260' Anhy 611', Tarkio 2182', Top 2511', Heeb 2748', ans 2830' TD 2905' 7" @ 2905' DST 2836-56', opn 1 hr., rec. 270' ho & gcm, 775# CO to 2892 Perf 2836-56, 500A P/50 bopd Comp. 25 bopd	
COMPLETED		

County	Russell		State	Kansas					
Sec.	29	(Blk. Twp.) 14	(Sur. Rge.) 12W	Map No.					
Operator	Smokey Hill Oil								
Well No.	2	Farm	Kepka						
Elev.	1687	Location NE NW SE							
<table border="1"> <tr> <td colspan="2">COMPLETE</td> </tr> <tr> <td>0</td> <td></td> </tr> </table>						COMPLETE		0	
COMPLETE									
0									
330 Ft. From N Line		SE							
990 Ft. From W Line		Quarter							
1st. Report		FEB 24 1954							
Completion									
Remarks		Hall-Gurney Pool							
Spudding Date		1-24-54							
Drig. Data	Oil well TD 2905								
10" @ 260	Anhy 611 Tarkio 2182								
Top. 2511	Herb. 2748 Lans. 2830								
TD 2905	7" @ 2905 DST 2836-56								
open 1 hr.	Rec. 270' ho & gcm 775#								
CO to 2892	perf. 2836-56 500 A								
P/ 50 bopd	Comp. 25 bopd								

J. G. McGEHEE

County	Russell		State	Kansas					
Sec.	29	(Blk. Twp.) 14	(Sur. Rge.) 12W	Map No.					
Operator	Smokey Hill Oil								
Well No.	2	Farm	Kepka						
Elev.		Location NE NW SE							
<table border="1"> <tr> <td colspan="2">FIRST REPORT</td> </tr> <tr> <td>0</td> <td></td> </tr> </table>						FIRST REPORT		0	
FIRST REPORT									
0									
330 Ft. From N Line		SE							
990 Ft. From W Line		Quarter							
1st. Report		JAN 6 1954							
Completion									
Remarks									
Spudding Date									
Drig. Data	Hall-Gurney Pool								
MCT									

J. G. McGEHEE