

KANSAS

FORM 51 5M 1-42 PETROL

O. W. D. D. Russell

Form 252-A  
5M 5-42 Petrol

KANSAS

Russell

Sec. 29 Twp. 14 R. 12-W

Section 29 Township 14 Range 12-W

Well No. #2 Marsh "C" Farm

Well No. #2 Marsh "C"

Cities Service Oil Company

Company Cities Service Oil

Hall-Gurney


Ft. from N. Line

1750 Ft. from S. Line


660 Ft. from E. Line

Ft. from W. Line

Elev. 1670

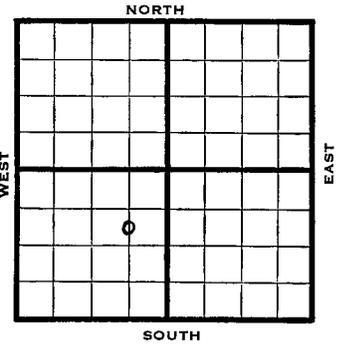

NORTH

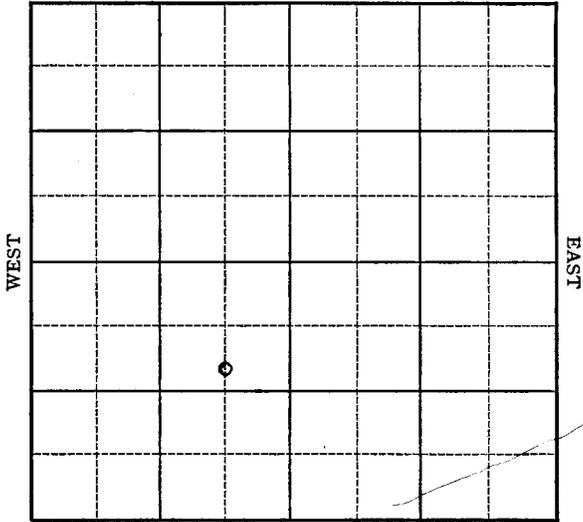

SOUTH

REPORT

1943	REPORT
8/4	Location Long section
8/11	8" @ 315' WOC
8/18	Drilg. 2570'
8/25	Lans 2327 Arb 3159 T.D. 3185'
1950	<b>ABANDONED</b> O. W. D. D
11/8	OTD 3185' was D&A Regan 3372' Granite Wash 3400' Granite 3429' TD 3432' 5" @ 3179' CO to 3432 3000 A Took 223 BW in 40 min Comp. for SWD FIRST REPORT <b>ABANDONED</b>

KANSAS

Russell

Map No. 5 Sec. 29 Twp. 14 R. 12W

Well No. 2 Marsh "C"

Cities Service Oil Company

FIRST REPORT Contractor

C SL NE SW


SECTION PLAT

       Ft. from N. Line

1750 Ft. from S. Line

660 Ft. from E. Line

       Ft. from W. Line

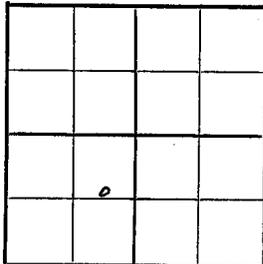

HALL-GURNEY POOL

Location XXXX

Rig up       

Drilling and Remarks:  
Long section

RECORD

Cased        in.,        ft.

Sand       

Gas       

Oil       

Total Depth       

PRODUCTION

1st 24 hrs. Nat.       

1st 24 hrs. after shot       

Gas        Cu. Ft.

Dry Hole       

Abandoned       

Date

AUG 4 1943

S. J. LEWIS Scout

Russell

KANSAS

Map No. 5 Sec. 29 Twp. 14 R. 12W

Well No. 2 Marsh "C"

Cities Service Oil Company

ABANDONED Contractor

C S L NE SW


SECTION PLAT

       Ft. from N. Line

1750 Ft. from S. Line

660 Ft. from E. Line

       Ft. from W. Line

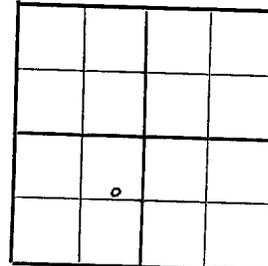

Hall-Gurney Pool

Location       

Rig up       

Drilling and Remarks:  
Loss 2827  
cut 3159

RECORD

Cased        in.,        ft.

Sand       

Gas       

Oil       

Total Depth 3185

PRODUCTION

1st 24 hrs. Nat.       

1st 24 hrs. after shot       

Gas        Cu. Ft.

Dry Hole       

Abandoned       

Date

AUG 25 1943

S. J. LEWIS Scout


County **Russell** State **Kansas**

Sec. **29** (Blk. Twp.) **14** (Sur. Rge.) **12w** Map No.

Operator **Cities Service**

Well No. **2** Farm **Marsh "C"**

Elev. **1670** Location **C S L NE SW**

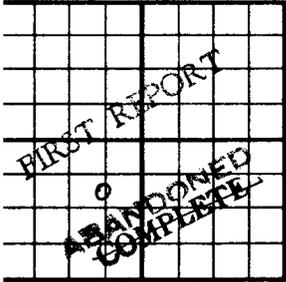

**990** Ft. From **N** Line **SW**

**660** Ft. From **E** Line Quarter

1st. Report **NOV 8 1950**

Completion **NOV 8 1950**

Remarks **OWDD for SWD**

Spudding Date

Orig. Data **SWD well TD 3432**

**OTD 3185 was D & A**

**Regan 3372 Granite wash 3400 Granite 3429**

**TD 3432 5" @ 3179 CO to 3432 3000 A**

**Took 225 bw in 40 min.**

*Comp. for SWD*

J. E. TYRA