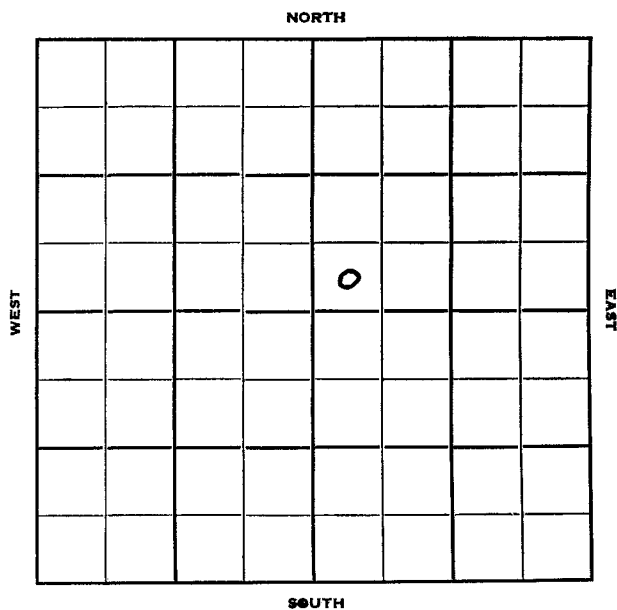


Section 29 Township 14 Range 12 WWell No. # 1 HeimCompany Stearn Pet.Sec. 29 Twp. 14 R. 12 WWell No. # 1 Heim FarmStearn Pet. CompanyStearn Contractor

Ft. from N. Line

330


Ft. from S. Line

Ft. from E. Line

330

Ft. from W. Line

SW SW NE

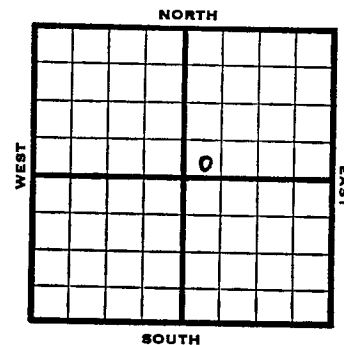

1952

Elev. 1669'

REPORT

5/28

Tite hole.

Drlg. 2800'

6/11

Arb. 3177 RTD 3185 5" @ 3185
CO 3185 23/3137-44 500 A
HFW Sq.

6/18

NR

6/25

NR

7/2

"

7/9

"

7/17

"

7/23

"

7/30

NR

8/6

"

8/13

"

8/20

"

8/27

Lans. 2811 Cong. 3108
Arb. 3134

9/3

10 Boph from KC

9/10

NR

9/17

"

9/24

"

OVER

.952
0/1 Oil well TD 3185' Lans. 2811'
Cong 3108' Arb. 3134'
TD 3185' 5" @ 3185 23/3137-44
500 A HFW Sq. perf. 10 BOPH from
KC
Comp. 50 BOPD from KC

COMPLETED

County	Russell	State	Kansas
Sec.	29	(Bk.) Twp.	14
		(Sur.) Rge.	12W
Operator	Stearn Pet.		
Well No.	1	Farm	Heim
Elev.	Location SW SW NE		
	330 Ft. From 2 Line NE		
	330 Ft. From W Line Quarter		
	1st. Report MAY 28 1952		
	Completion		
	Remarks		
	Stearn - Contr.		
	Spudding Date		

Drlg. Data

Title hole Drlg. 2800

J. G. McGEHEE

County	Russell	State	Kansas
Sec.	29 (Blk. Twp.)	14 (Sur. Rge.)	12W Map No.
Operator	Stearn Pet.		
Well No.	1 Farm Heim		
Lev.	1669	Location	SW SW NE
		330 Ft. From S Line NE	
		330 Ft. From W Line Quarter	
		1st. Report	
		Completion OCT 1 1955	
		Remarks Tite hole	
		Stearn - Contr.	
		Spudding Date	
Orig. Data	Oil well TD 3185		
Lens.	2811	Comp.	3108 Arb. 3134
TD 3185	5" @ 3185	23/	3137-44 500 A
HFW	sq. perf. 10 boph from KC		
Comp. 50 bopd from KC			

J. G. McGEHEE