

Section **29** Township **14** Range **12W**

Sec. **29** Twp. **14** R. **12W**


Well No. **#2 Hein**

Well No. **#2 Hein** Farm

Company **Stearns Pet.**

Stearns Petr. Company

Stearns Contractor

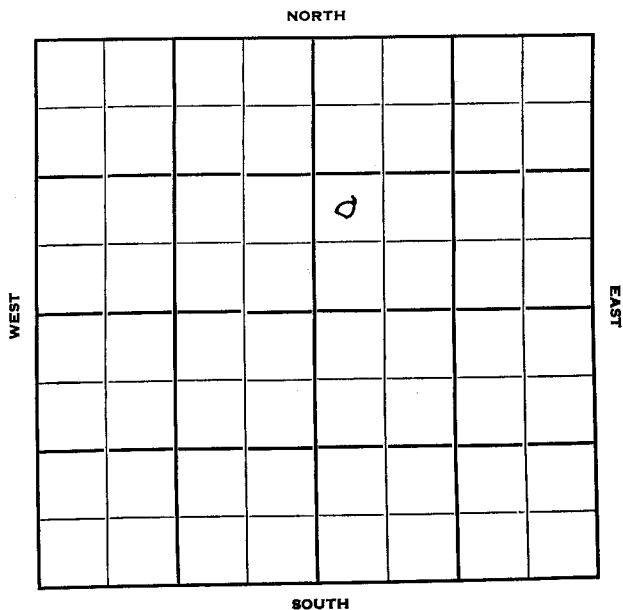

Ft. from N. Line


990 Ft. from S. Line

Ft. from E. Line

330 Ft. from W. Line

NE $\frac{1}{4}$

NW SW NE

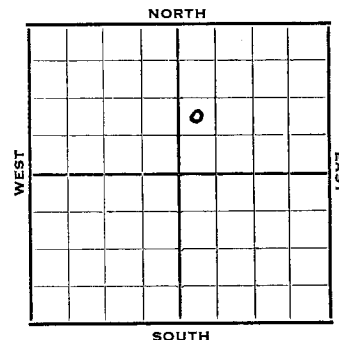

1952 Elev. 1660' REPORT

10/22 Spud 10-17-52
8" @ 206'
Anhy 580'
Drlg. 1390'

10/29 KC 2802' Drlg.

11/5 Arb. 3150
RTD 3172
5" @ 3172'

11/12 12/ 3161-65 wtr. 200' wtr.
set plug.

11/20 NR

11/27 "

12/4 "

12/11 Perf Lans 15 BOPH

12/18 NR

12/25 NR

1/1 Testing

1/8 NR

OVER

#2 Hein

Spud 10-17-52
 Oil Well TD 3172
 8" @ 206
 Anhy 580, KC 2802, Arb. 3150,
 TD 3172, 5" @ 3172
 12/3161-65, wtr
 FU 200' wtr. ph SP perf KC
 15 boph PB 3050 12/3029-33
 11/2994-99, PB 2925, 48/2898-
 2912, dry 1000A 9 go 19 gwph
 PB 2865, 21/2839-43, 1000A
 1 bo 2 bwph S/1/2 bo 17 bwph
 PB 2834, 26/2816-22, 1 go & mud
 PB 2180, 36/2170-74 sd-frac
 2 1/4 bo 1 1/2 bw 5 boph 25% wtr
 Comp. 50 bopd 25%wtr.

COMPLETED

County	Russell		State	Kansas	
Sec.	29	(Blk. Twp.)	14	(Sur. Rge.)	12W Map No.	
Operator	Stearns Pet.	
Well No.	2	Farm	Hein	
Elev.	Location NW SWNE	
<table border="1"> <tr><td></td><td></td><td></td><td></td><td></td><td></td></tr> <tr><td></td><td></td><td></td><td></td><td></td><td></td></tr> <tr><td></td><td></td><td></td><td></td><td></td><td></td></tr> <tr><td></td><td></td><td></td><td></td><td></td><td></td></tr> <tr><td></td><td></td><td></td><td></td><td></td><td></td></tr> <tr><td></td><td></td><td></td><td></td><td></td><td></td></tr> <tr><td></td><td></td><td></td><td></td><td></td><td></td></tr> <tr><td></td><td></td><td></td><td></td><td></td><td></td></tr> </table>																																																			990 Ft. From S Line NE		
330 Ft. From W Line Quarter	
1st. Report OCT 22 1952	
Completion	
Remarks	
Stearns - Contr.	
Spudding Date 10-17-52	

Drlg. Data

8" @ 206 Anhy 580 drlg. 1390

J. G. McGENEE

County	Russell		State	Kansas	
Sec.	29	(Blk. Twp.)	14	(Sur. Rge.)	12W Map No.
Operator	Stearns Pet.				
Well No.	2 Farm Hein				
Elev.	1660		Location	NW SW NE	
			990 Ft. From S Line NE		
			330 Ft. From W Line Quarter		
			1st. Report		
			Completion JAN 14 1953		
			Remarks		
			Stearns - Contr.		
			Spudding Date 10-17-52		
Orig. Data	Oil well TD 3172				
8" @ 206 Anhy 580 KC 2802 Arb. 3150					
TD 3172 5" @ 3172 12/ 3161-65 wtr.					
FU 200' wtr. ph SP perf. KC 15 boph					
PB 3050 12/ 3029-33 11/ 2994-99					
PB 2925 48/ 2898-2912 dry 1000 A					
9 go 19 gwph PB 2865 21/ 2839-43					
1000 A 1 bo 2 bwph S/ 1/2 bo 17 bwph					
PB 2834 26/ 2816-22 1 go & mud					
PB 2180 36/ 2170-74 sd-frac					
2 1/4 bo 1 1/2 bw 5 boph 25% wtr.					
Comp. 50 bopd 25% wtr.					

J. G. McGEHEE