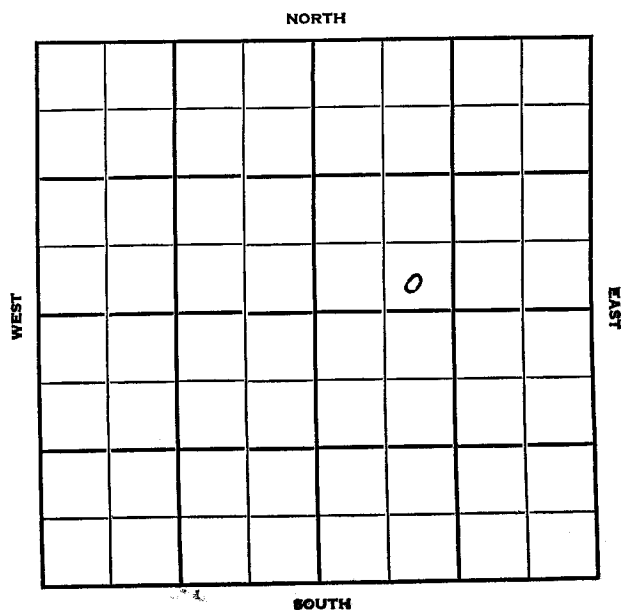


Section 29 Township 14 Range 12WWell No. #3 HeimCompany Stearns

Russell KANSAS

SEC. <u>29</u>	TWP. <u>14</u>	R. <u>12 W</u> ✓
----------------	----------------	------------------

WELL NO. # 3 Heim FARM

COMPANY Stearns

CONTRACTOR Stearns

Hall-Gurney Pool


_____ Ft. from N. Line

330 _____ Ft. from S. Line

_____ Ft. from E. Line

990 _____ Ft. from W. Line

SE SW NE

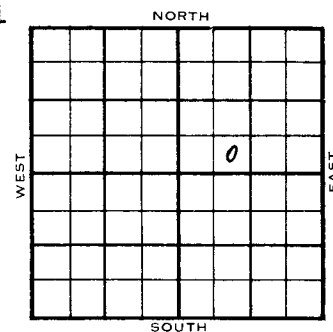

	ELEVATION	REPORT
1954	1666'	
5/19	Spud 5-10-54 8" @ 200 Anhy 586' Core 2152-95, rec 10' Core 2230-58, rec 18' Drlg. 2450'	
6/15	Spud 5-10-54 Oil Well TD 3162' 8" @ 200' Anhy 586', Tarkio 2155', Top 2510', Heeb 2725', Tor 2742', Lans 2808', Re-Arb. 3130', Arb. 3135' TD 3140' 5" @ 3136' CO to 3140', 500A S/4 bwph, X DD 3162, S/10 bwph, SP 2875, 27/2838-43 B/11 go 1000A S/20 BOPH 12 hrs. omp. 50 bopd	
		COMPLETED

J. G. McGEHEE

J. G. McGEHEE