


Section 29 Township 14 Range 12 W

Well No. # 4 Heim

Company Stearns Drlg.

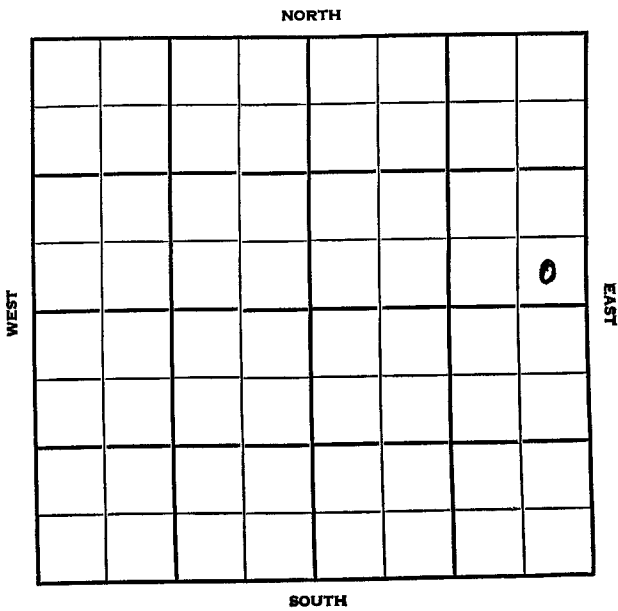

Russell KANSAS

SEC.	TWP.	RANGE
29	14	12 W

WELL NO. # 4 Heim FARM

COMPANY Stearns Drlg.

CONTRACTOR

Stearns Hall-Gurney Pool

_____	Ft. from N. Line
330	Ft. from S. Line
330	Ft. from E. Line
_____	Ft. from W. Line

SE SE NE

	ELEVATION	REPORT
1954	1671'	
8/11		Cellar & Pits
10/6		Spud 9-14-54 - Oil Well TD 3155' 8" @ 191' Anhy 581', Heeb 2732', Tor 2747', Lans 2813', Cong. 3118', Arb. 3148' TD 3155' 5" @ 2970' CO to 2960' 18/2905-08' PB 2880' <del>XX</del> 29/2843-49, 1000A S/8 boph Comp. 100 bopd

**COMPLETED**

