



Section 29 Township 14 Range 12W  
 Well No. 5 Heim  
 Company Stearns Petr.

SEC. 29 TWP. 14 R. 12 W  
 WELL NO. # 5 Heim FARM  
 COMPANY Stearns Petr.  
 CONTRACTOR Co. tools

Hall-Gurney Pool

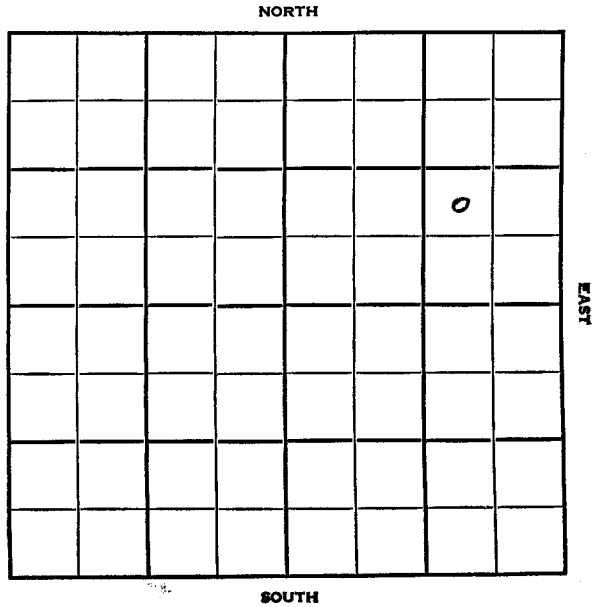

\_\_\_\_\_ Ft. from N. Line  
990 \_\_\_\_\_ Ft. from S. Line  
990 \_\_\_\_\_ Ft. from E. Line  
 \_\_\_\_\_ Ft. from W. Line

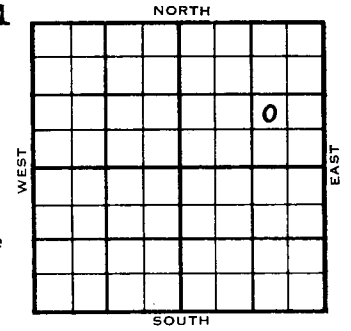

NW SE NE

	ELEVATION	REPORT
1955	1657'	
4/20	Spud 4-15-55 8" @ 195 Anhy 567' Drlg. 1498'	
5/25	Heeb 2716; Doug sh 2726; Br Ls 2797; Lsg 2810; Arb 3136; TD 3184; 8" 195; DST 3137-45 open 40 min, rec 40' mud, 80#; 5 1/2" 3184; logs; CO; 12/3159-62; 500A; swb 8 bwph 8 hrs; p plug 3020; 12/2988-91; 1000A; swb 7 boph 8 hrs; plug 2850; 20/2831-36; 1000A; swb 7.5 boph no wtr 8 hrs; pmp 75 bopd no wtr. from Lsg 2831-36	COMPLETED

