

Section 29 Township 14 Range 12W

Well No. #4 Marsh "C"

Company Cities Service

SEC. TWP. R.

29

14

12 W

WELL NO.

4 Marsh "C"

FARM

COMPANY

Cities Service

CONTRACTOR

Barbour

Hall-Gurney Pool

Ft. from N. Line

990

Ft. from S. Line


Ft. from E. Line

660


Ft. from W. Line

C N 1/2 SW SW

NORTH

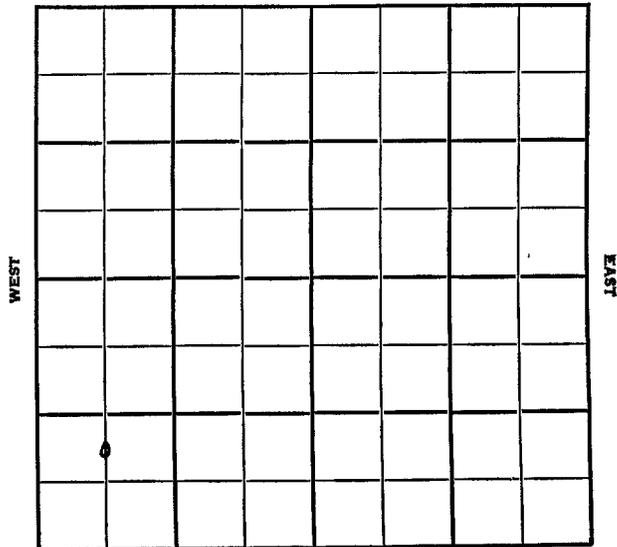

NORTH

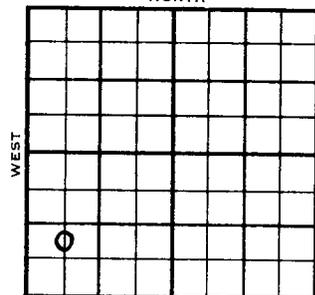

	ELEVATION	REPORT
1955	1688'	
2/9	Spud 2-5-55 8" @ 544	
3/2	Drlg. 1014' Spud 2-5-55 Oil Well TD 3168' 8" @ 544' 2nd Tarkio 2212', Tarkio Lm 2258' Willard. 2281', Heeb 2754', Dodge. 2771 Lans 2838' DST 2847'-65' opn 1 hr, rec 105' o & gcm, 740# DST 2874'-85' opn 1 hr, rec 30# sgcm 135# TD 3130' 5" @ 3129' DD 3131' 7 gwph Cong. 3133' Arb. 3162 TD 3168 PB 3100' 36/ 2850-61 7 go 1/2 gw 1/2 hr. 1000 A Comp 92 bopd. 24 bw.	

COMPLETED

