

Sec. 29 Twp. 14 R. 12-W

Section 29 Township 14 Range 12-W

Well No. #1 Marsh "C"

Company Cities Service Oil

Well No. #1 Marsh "C" Farm

Cities Service Oil Company

Greenvale



\_\_\_\_\_ Ft. from N. Line

330 Ft. from S. Line

\_\_\_\_\_ Ft. from E. Line

660 Ft. from W. Line

Elev. 1720

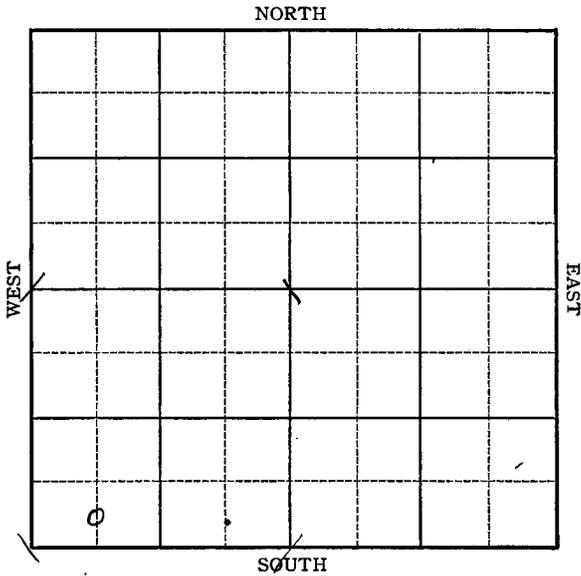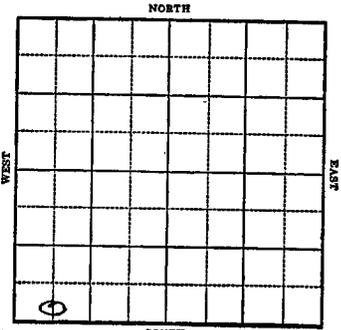

1943	REPORT
6/30	Location.
7/7	"
7/15	8" @ 314 Drlg. 1965'
7/21	Lans 2870 Gorham 3164-66 T.D. 5" @ 3164 Rust
7/28	2400' oil 1 hr.
8/4	Temp Pcb 164
8/11	" " "
8/18	" " "
8/25	" " "
9/1	" " "
9/8	" " "
9/15	Gorham 3164 5" @ 3164 Pump 238 Pot. T.D. 3166' Gravity 37
	<b>COMPLETED</b>

Russell

Map No. 58 Sec. 29 Twp. 14 R. 12W


Well No. 1 Marsh "C"

Cities Service Oil Company

COMPLETED Contractor

C S L SW SW

SECTION PLAT

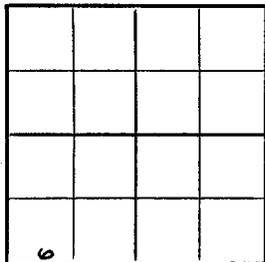

Ft. from N. Line

330 Ft. from S. Line

Ft. from E. Line

660 Ft. from W. Line

Greenvale Pool

Location

RECORD

Cased \_\_\_\_\_ in., \_\_\_\_\_ ft.

Sand \_\_\_\_\_

Gas \_\_\_\_\_

Oil \_\_\_\_\_

Total Depth 3166

PRODUCTION

1st 24 hrs. Nat. \_\_\_\_\_

1st 24 hrs. after shot \_\_\_\_\_

Gas \_\_\_\_\_ Cu. Ft.

Dry Hole \_\_\_\_\_

Abandoned \_\_\_\_\_

Rig up \_\_\_\_\_

Drilling and Remarks:

*30' hole 3/164*

*5" @ 3/164*

*Pump 238 ft*

*37° G*

Date

SEP 15 1943 19 S. J. LEWIS Scout

Russell

Map No. 58 Sec. 29 Twp. 14 R. 12W


Well No. 1 Marsh "C"

Cities Service Oil Company

FIRST REPORT Contractor

C SL SW SW

SECTION PLAT

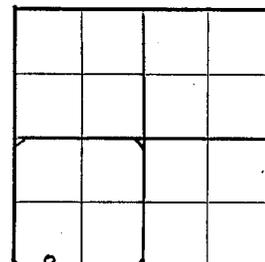

Ft. from N. Line

330 Ft. from S. Line

Ft. from E. Line

660 Ft. from W. Line

GREENVALE POOL

Location XXX

RECORD

Cased \_\_\_\_\_ in., \_\_\_\_\_ ft.

Sand \_\_\_\_\_

Gas \_\_\_\_\_

Oil \_\_\_\_\_

Total Depth \_\_\_\_\_

PRODUCTION

1st 24 hrs. Nat. \_\_\_\_\_

1st 24 hrs. after shot \_\_\_\_\_

Gas \_\_\_\_\_ Cu. Ft.

Dry Hole \_\_\_\_\_

Abandoned \_\_\_\_\_

Rig up \_\_\_\_\_

Drilling and Remarks:

Date

JUN 30 1943 19 S. J. LEWIS Scout