


Russell

KANSAS

Section 29 Township 14 Range 12W

Well No. #1 Marsh "C"

Company Jones, Shelburne & Farmer

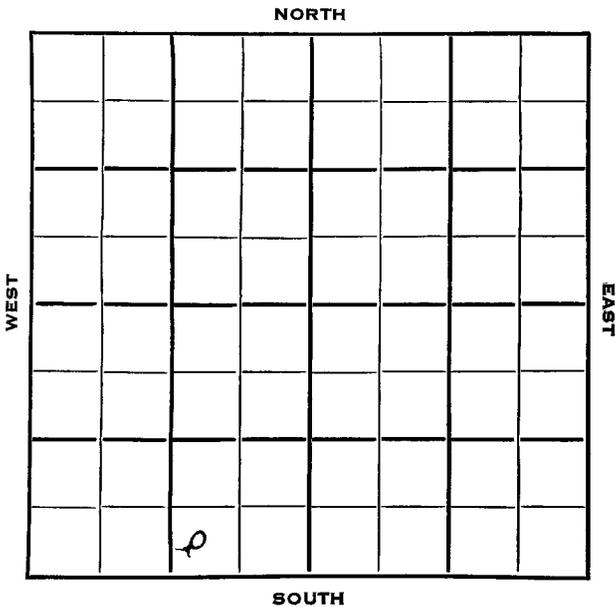

SOUTH

Russell KANSAS

SEC. 29	TWP. 14	R. 12W
---------	---------	--------

WELL NO. #1 Marsh "C" FARM

COMPANY Jones, Shelburne & Farmer

CONTRACTOR J-S-F

Hall-Gurney Pool

_____ Ft. from N. Line


330

_____ Ft. from S. Line

990

_____ Ft. from E. Line

_____ Ft. from W. Line

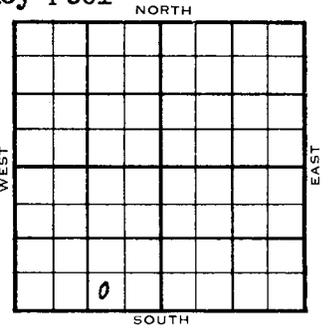

SW SE SW

1954	ELEVATION 1686'	REPORT
------	-----------------	--------

3/31 Spud 3-24-54
Drlg 620'

4/7 Anhy 632 12" @ 640
Brlg. 1490'

6/15 Spud 3-24-54
Oil Well
TD 3147'
Anhy 632'
12" @ 640'
10" @ 1905'
Tarkio 2222'
8" @ 2275'
Dodge 2770', Lans 2837', Arb. 3139'
5" @ 3139'
TD 3140'
DD 3147, 15/2890-98, 21, 2849-56
3000A
S/3 boph 16 hrs.
Comp. 30 bopd lot of gas

COMPLETED

