


Section 29 Township 14 Range 12W

Well No. 2 Marsh "C"

Company Julian Oil & Ref.

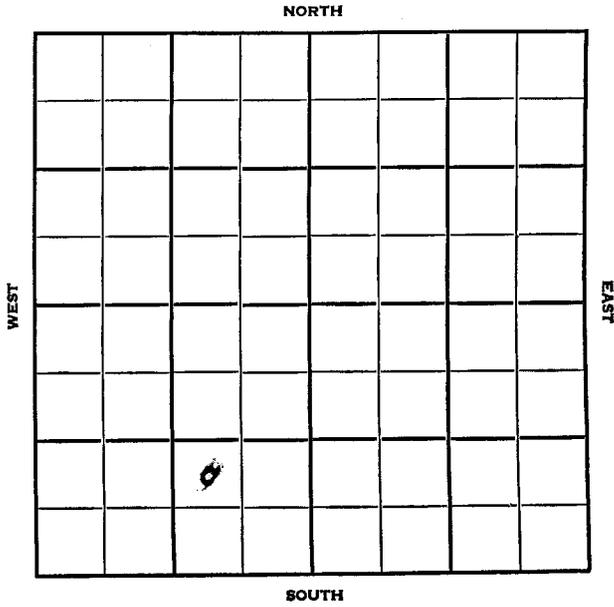

Russell KANSAS


SEC.	TWP.	R.
29	14	12 W

WELL NO. # 2 Marsh "C" FARM

COMPANY Julian Oil & Refg.

CONTRACTOR

Co. tools
Hall-Gurney Pool
_____ Ft. from N. Line
990 _____ Ft. from S. Line
990 _____ Ft. from E. Line
_____ Ft. from W. Line

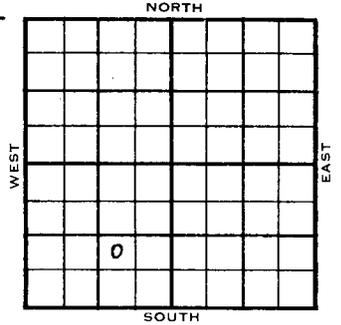

NW SE SW

1954	ELEVATION 1694'	REPORT
10/20	Location	
1955 1/12	Spud 11-4-54 Oil Well TD 2880' 15" @ 347' 13" @ 635' Tarkio 2200' Anhy 630' 8" @ 2278' Top 2485' KC 2860' TD 2880' 5" @ 2870' CO to 2880' FU 2200' oil 3 hr. Comp 25 bopd.	

COMPLETED

