

STATE CORPORATION COMMISSION OF KANSAS  
OIL & GAS CONSERVATION DIVISION

WELL COMPLETION OR RECOMPLETION FORM  
ACO-1 WELL HISTORY

DESCRIPTION OF WELL AND LEASE

Operator: License # 5208  
Name Mobil Oil Corporation  
Address P. O. Box 5444  
City/State/Zip Denver, CO 80217-5444

Purchaser.....

Operator Contact Person D. C. Forbes  
Phone (303) 298-2056

Contractor: License # .....  
Name .....

Wellsite Geologist.....  
Phone.....

Designate Type of Completion

- New Well  Re-Entry  Workover
- Oil  SWD  Temp Abd
- Gas  Inj  Delayed Comp.
- Dry  Other (Core, Water Supply etc.)

If ONWO: old well info as follows:

Operator .....  
Well Name .....  
Comp. Date ..... Old Total Depth.....

WELL HISTORY

Drilling Method:

- Mud Rotary  Air Rotary  Cable

5-17-85 5-17-85 5-24-85  
Date work commenced Date Reached TD Completion Date  
3192' 3091'  
Total Depth PBTD

Amount of Surface Pipe Set and Cemented at 398 feet  
Multiple Stage Cementing Collar Used?  Yes  No  
If yes, show depth set.....feet  
If alternate 2 completion, cement circulated  
from.....feet depth to.....w/.....SX cmt

API NO. 15- N/A  
County Russell  
NW SW NW Sec. 32 Twp. 14S Rge. 12  East  West

330 Ft FWL from Southeast Corner of Section  
1650 Ft FNL from Southeast Corner of Section  
(Note: Locate well in section plat below)


Lease Name Smoky Hill River Unit Well # 19

Field Name Hall-Gurney

Producing Formation Lansing/Kansas City

Elevation: Ground 1710' KB 1715'

Section Plat

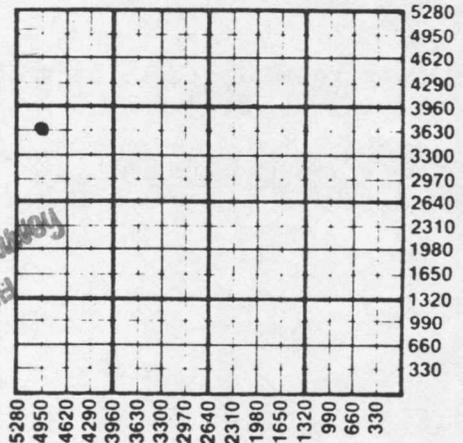

SEP 23 1985  
State Geological Survey  
WICHITA BRANCH

WATER SUPPLY INFORMATION

Disposition of Produced Water:  Disposal  Repressuring  
Docket # 80,725-C (C-13,313)

Questions on this portion of the ACO-1 call:  
Water Resources Board (913) 296-3717

Source of Water:  
Division of Water Resources Permit # N/A

Groundwater.....Ft North from Southeast Corner  
(Well) .....Ft West from Southeast Corner of  
Sec Twp Rge  East  West

Surface Water.....Ft North from Southeast Corner  
(Stream, pond etc).....Ft West from Southeast Corner  
Sec Twp Rge  East  West

Other (explain).....  
(purchased from city, R.W.D. #)

INSTRUCTIONS: This form shall be completed in duplicate and filed with the Kansas Corporation Commission, 200 Colorado Derby Building, Wichita, Kansas 67202, within 90 days after completion or recompletion of any well. Rule 82-3-130 and 82-3-107 apply.

Information on side two of this form will be held confidential for a period of 12 months if requested in writing and submitted with the form. See rule 82-3-107 for confidentiality in excess of 12 months.

One copy of all wireline logs and drillers time log shall be attached with this form. Submit CP-4 form with all plugged wells. Submit CP-111 form with all temporarily abandoned wells.

SIDE TWO

Operator Name Mobil Oil Corporation Lease Name Smoky Hill River Unit 19 Well #

Sec. 32 Twp. 14S Rge. 12 East West County Russell

WELL LOG

INSTRUCTIONS: Show important tops and base of formations penetrated. Detail all cores. Report all drill stem tests giving interval tested, time tool open and closed, flowing and shut-in pressures, whether shut-in pressure reached static level, hydrostatic pressures, bottom hole temperature, fluid recovery, and flow rates if gas to surface during test. Attach extra sheet if more space is needed. Attach copy of log.

Drill Stem Tests Taken  Yes  No  
 Samples Sent to Geological Survey  Yes  No  
 Cores Taken  Yes  No

Formation Description  
 Log  Sample

Name Top Bottom

Well was recompleted to increase production by opening up more zone.

Recompletion Procedure  
 (See attached page)

CASING RECORD <input type="checkbox"/> New <input type="checkbox"/> Used							
Report all strings set-conductor, surface, intermediate, production, etc.							
Purpose of String	Size Hole Drilled	Size Casing Set (in O.D.)	Weight Lbs/Ft.	Setting Depth	Type of Cement	#Sacks Used	Type and Percent Additives
NO CHANGE IN CASING RECORD							
PERFORATION RECORD				Acid, Fracture, Shot, Cement Squeeze Record			
Shots Per Foot	Specify Footage of Each Interval Perforated			(Amount and Kind of Material Used)		Depth	
4	2886-92'						
	2907-25'						
	2970-88'						
TUBING RECORD				Liner Run	<input type="checkbox"/> Yes <input type="checkbox"/> No		
Size	Set At	Packer at					