

PI

KANSAS DRILLERS LOG

API No. 15 — County — Number

Operator Southern States Oil Co.

Address Box 1365 Great Bend, Kansas 67530

Well No. 1 Lease Name Weinhold "G"


Footage Location feet from (N) (S) line feet from (E) (W) line

Principal Contractor Geologist

Spud Date June 17, 1981 Total Depth 3212 P.B.T.D.

Date Completed June 23, 1981 Oil Purchaser

S. 33 T. 14S R. 12 E W
Loc. 150' E-SW NE NW
County Russell

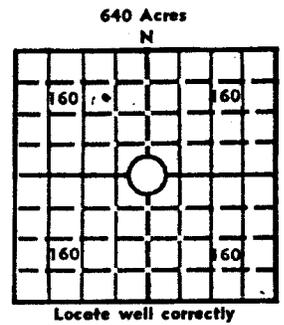

Locate well correctly
Elev.: Gr.
DF KB

CASING RECORD

Report of all strings set — surface, intermediate, production, etc.

Purpose of string	Size hole drilled	Size casing set (in O.D.)	Weight lbs/ft.	Setting depth	Type cement	Sacks	Type and percent additives
Surface	12-1/4"	8-5/8"		268.38	Common	165	

LINER RECORD

PERFORATION RECORD

Top, ft.	Bottom, ft.	Sacks cement	Shots per ft.	Size & type	Depth interval

Size	Setting depth	Packer set at

ACID, FRACTURE, SHOT, CEMENT SQUEEZE RECORD

Amount and kind of material used	Depth interval treated

INITIAL PRODUCTION

Date of first production		Producing method (flowing, pumping, gas lift, etc.)			
RATE OF PRODUCTION PER 24 HOURS	Oil bbls.	Gas MCF	Water bbls.	Gas-oil ratio	CFPB
Disposition of gas (vented, used on lease or sold)			Producing interval (s)		

INSTRUCTIONS: As provided in KCC Rule 82-2-125, within 90 days after completion of a well, one completed copy of this Drillers Log shall be transmitted to the State Geological Survey of Kansas, 4150 Monroe Street, Wichita, Kansas 67209. Copies of this form are available from the Conservation Division, State Corporation Commission, 3830 So. Meridian (P.O. Box 17027), Wichita, Kansas 66217. Phone AC 316-522-2206. If confidential custody is desired, please note Rule 82-2-125. Drillers Logs will be on an open file in the Oil and Gas Division, State Geological Survey of Kansas, Lawrence, Kansas 66044.

Date Received	
Partner	Date
Title	7-1-81
Signature	<i>H. J. W. ...</i>

USE ADDITIONAL SHEETS, IF NECESSARY, TO COMPLETE WELL RECORD.

FORMATION DESCRIPTION, CONTENTS, ETC.	TOP	BOTTOM	NAME	DEPTH
Surface	0	15		15
Shale	15	150		150
Sand	150	161		161
Shale	161	268		268
Shale	268	300		300
Shale	300	800		800
Anhy	617	640		640
Shale & lime	800	1365		1365
Shale & lime	1365	1715		1715
Shale & lime	1715	1970		1970
Lime & shale	1970	2160		2160
Shale & lime	2160	2325		2325
Shale & lime	2325	2532		2532
Lime	2532	2600		2600
Lime & shale	2600	2815		2815
Lime & shale	2815	2925		2925
Lime & shale	2925	2960		2960
Lime	2960	2975		2975
Lime	2975	3040		3040
Lime	3040	3115		3115
Lime	3115	3190		3190
Lime	3190	3218		3218
Lime	3218	3218		3218

Operator	Southern States Oil Co.
Well No.	1
Lessee Name	Weinhold "G"
s 33 T 14S R 12 W EX	
WELL LOG	
Show all important zones of porosity and contents thereof; cored intervals, and all drill-stem tests, including depth interval tested, cushion used, time tool open, flowing and shut-in pressures, and recoveries.	
SHOW GEOLOGICAL MARKERS, LOGS RUN, OR OTHER DESCRIPTIVE INFORMATION.	
DESIGNATE TYPE OF COMP.: OIL, GAS, DRY HOLE, SWD, ETC.	Oil Well