


Section.....12.....Township.....14.....Range...15W.....

Well Number...1...Peterson.....

Company.....Alyward Prod.....

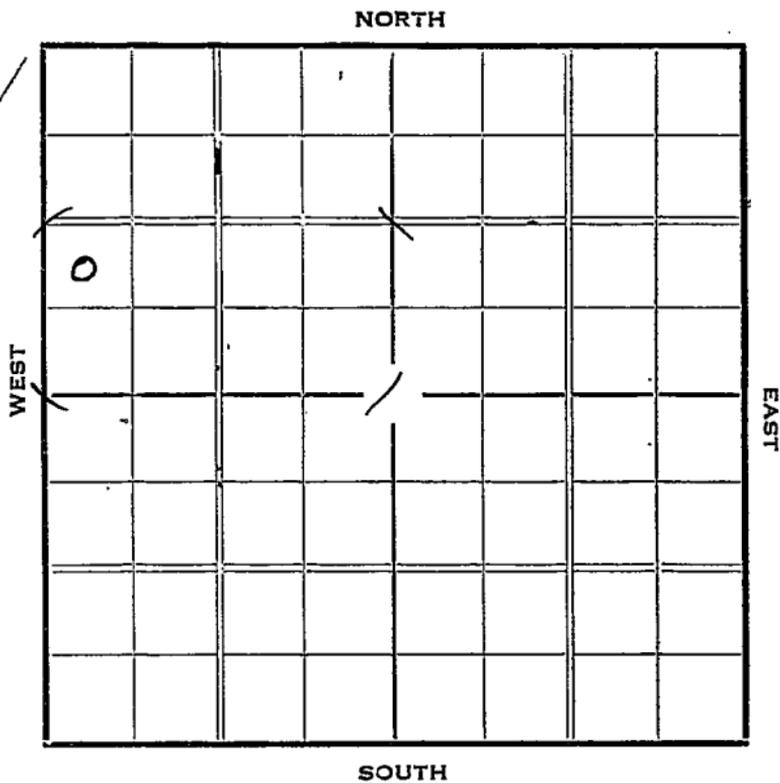

Sec. 12 Twp. 14 R. 15-W

Well No. 1 Peterson Farm

Alyward Prod. Company


\_\_\_\_\_ Ft. from N. Line

990 Ft. from S. Line

\_\_\_\_\_ Ft. from E. Line

330 Ft. from W. Line

Elev. 1876

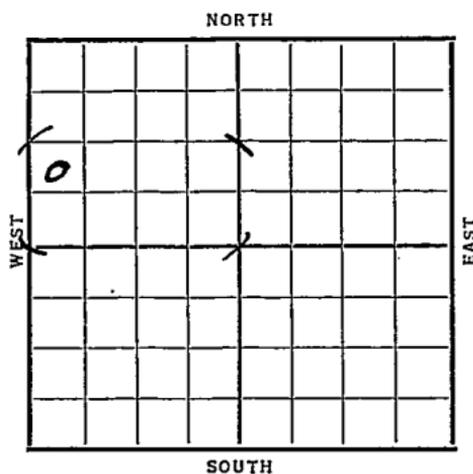

Date	REPORT
11/10	Location
11/19	R O G
11/27	Rigging up
12/3	" "
12/10	--- 12/17-- 12/24--
12/29	Shut down.
1937	
1/7	Spud.
1/14	12" @ 565'. Anhydrate 904'.
1/21	Drlg. 2275'.
1/28	8" @ 2518'. Drlg. 2855'.
2/4	KCL 3045 Set 6" Drlg. 3160
2/10	Sil. 3300' H.F.W.
	T. D. 3323'.
	<b>ABANDONED</b>

# KANSAS

Map No. 72 Sec. 12 Twp. 14 R. 15W

Well No. 1 Peterson

Cityward Prod Company

Contractor

### SECTION PLAT

0			

\_\_\_\_\_ Ft. from N. Line

990 Ft. from S. Line

\_\_\_\_\_ Ft. from E. Line

830 Ft. from W. Line

## FIRST REPORT

Location ✓

Rig up \_\_\_\_\_

Drilling and Remarks:

### RECORD

Cased \_\_\_\_\_ in., \_\_\_\_\_ ft.

Sand \_\_\_\_\_

Gas \_\_\_\_\_

Oil \_\_\_\_\_

Total Depth \_\_\_\_\_

### PRODUCTION

1st 24 hrs. Nat. \_\_\_\_\_

1st 24 hrs. after shot \_\_\_\_\_

Gas \_\_\_\_\_ Cu.Ft.

Dry Hole \_\_\_\_\_

Abandoned \_\_\_\_\_

Date

7

NOV 10 1936

19

S. J. LEWIS Scout

# KANSAS

Map No. \_\_\_\_\_ Sec. 12 Twp. 14 R. 15W

Well No. 1 Peterson

Calward Prod. Company

Contractor

### SECTION PLAT

\_\_\_\_\_ Ft. from N. Line

990 Ft. from S. Line

\_\_\_\_\_ Ft. from E. Line

330 Ft. from W. Line

0			

## ABANDONED

Location \_\_\_\_\_

Rig up \_\_\_\_\_

Drilling and Remarks:

Sil 3300

H.F.W.

IIYA

### RECORD

Cased \_\_\_\_\_ in., \_\_\_\_\_ ft.

Sand \_\_\_\_\_

Gas \_\_\_\_\_

Oil \_\_\_\_\_

Total Depth 3323

### PRODUCTION

1st 24 hrs. Nat. \_\_\_\_\_

1st 24 hrs. after shot \_\_\_\_\_

Gas \_\_\_\_\_ Cu. Ft.

Dry Hole \_\_\_\_\_

Abandoned \_\_\_\_\_

Date

**FEB 10 1937**

19

**S. J. LEWIS** Scout