


SECTION 12 TOWNSHIP Russell RANGE 15 W
14

WELL NO. #1 Peterson

COMPANY Kim Oil

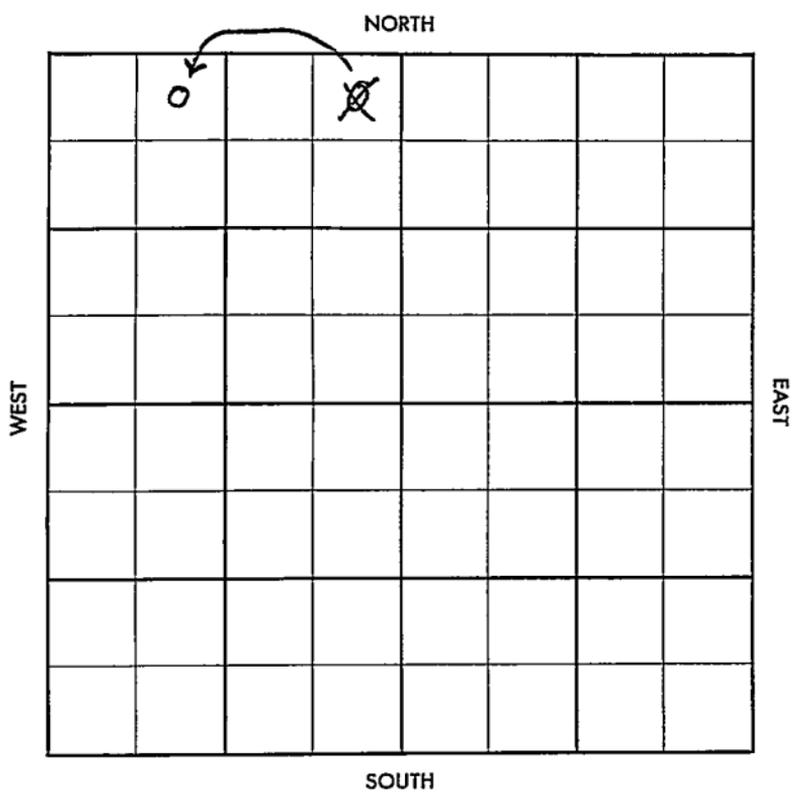

SEC. 12	TWP. 14	R. 15W
------------	------------	-----------

WELL NO.

#1 Peterson

FARM

COMPANY

Kim Oil

CONTRACTOR

Mast


Gorham

_____ Ft. from N. Line

_____ Ft. from S. Line

_____ Ft. from E. Line

_____ Ft. from W. Line

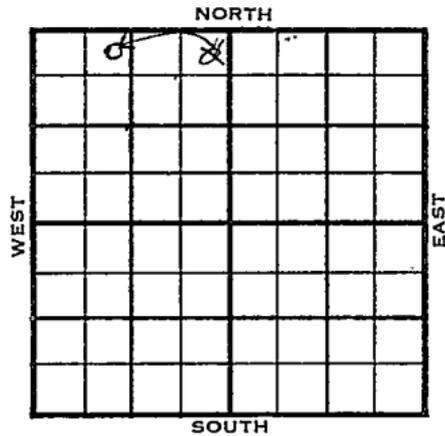NE ^{NW} NE NWSDX $\frac{1}{2}$ mile

	ELEVATION	REPORT
1956		
1-11-1-19	WOR Spud 1-11-56 8 5/8" @ 262/125 Anhy 900 Drlg. 2680'	
1-27	Top. 2759; Heeb. 2983; Tor. 3001 Lans. 3038, Arb. 3287, Reagan Sd 3296 TD 3300 DST 3047-87 op 95 min. gas to surface in 85 min, rec. 140' gassy mud, 250' gassy oil, 50' wtr., 510/20" 5 1/2" @ 3296/100	
..	WOCT	
2-2	CO, SP 3100, 32/ 3075-83, 3000 A FU 1800' oil 2 hrs.	
2-8	No report	
2-16	" "	

County Russell Elev. _____
 Sec. 12 Twp. 7N Rge. 15W
 Company Kiri Oil
 Farm Name Peterson No. 1

TOPS	DEPTH	LOG	DATUM
Anh.			
Tp.			
H.			
Tr.			
Dg.			
Bl.			
L.			
K.C.			
B.K.C.			
Ce.			
C.			
M.			
M.			
K.			
Mz.			
Me.			
V.			
S.			
S.			
A.			
R.			
Pe.			
G.			
T.D.			

Loc. in Sec. NE NE NW
 Geol. _____
 Contr. _____
Mast
 Pool Corham

0

JAN 11 '56

FIRST REPORT

1/2 mile

Date Comm. WOR

[Handwritten signature]

Co. Lse. No. Sec. T. R.

R19 - 15 - 1 - 2 - 5

CORRECTION

FORM 513 REV. SUNRAY

County Russell Elev. 1874
1871 DF
 Sec. 12 T. 14 R. 15W
 Company Kin Oil
 Farm Name Peterson No. 1

TOPS	DEPTH	LOG	DATUM
Asb	900		
Tp	2759		
N	2989		
Te	3001		
Bp			
Bl			
L	3038		1167
Kc			
BVL			
Ce			
C			
M			
M			
K			
M			
V			
S			
A	✓ 3287		1416
R	✓ 3296		1425
FC			
G			
TD	3300		

NENWN
 Loc. in Sec.
NE NW
 250' FWL
 1200' FWL OF NW
DICK GREE
 Geol.
 Coats
Mart
 Pool
Corham
 OK
COMPLETE
 1/4 mile
 1/2 mile

FEB 22 1956

Date Comp. W O R JAN 18 56 Spd 1-11-56 P 7/2 26
 1.125 Bohy 900 @ 2680 JAN 25 56
 DST 3047-87 @ 95" gas to au
 in 85" rec. 140' gas Md (50. specked
 + 250' gas oil + 50 wts. FP 35-17
 BHP 510/20" AT 6 3287 Rca sd. 32
 RTD 3300 no log 5 1/2 @ 3296/100
 WAGT FEB 1 56 X 60" plg @ 3100
 32/3075-83 no test nat 13 FU 180