

Section 12 Township 14 Range 15-W

Well No. #2 Mills


Company Eldorado Refining

NORTH

WEST

EAST

SOUTH

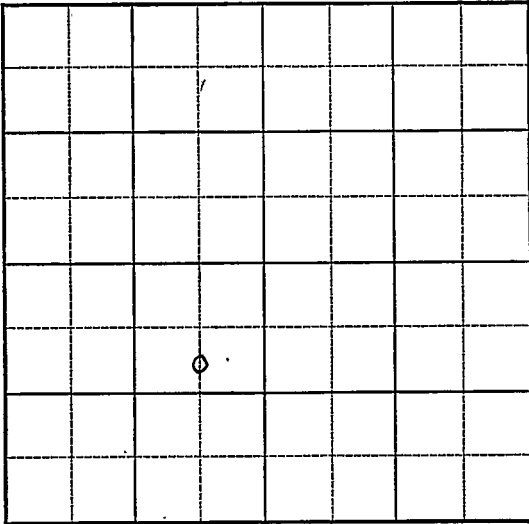

Sec. 12 Twp. 14 R. 15-W

Well No. #2 Mills Farm

Eldorado Refining Company


990 Ft. from N. Line

_____ Ft. from S. Line

660 Ft. from E. Line

_____ Ft. from W. Line

Elev. 1854

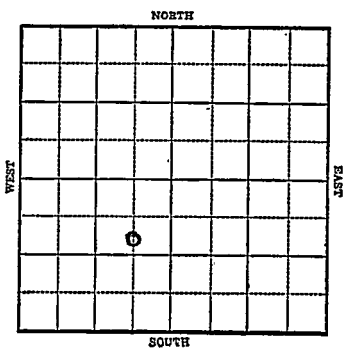

1943

R E P O R T

- 5/5 Surface Hole
- 5/12 8" @ 315 anhy
Anhy 885
Topeka 2736
Lans 3016
SO 3042-44 3059-64, 3089-92
Drlg. 3099
- 5/19 No report.
- 5/26 Arb 3270
5" @ 3271
T.D. 3299 water
Plug 3135'-48 shots 3043-59-500
acid
- 6/2 25 shots 3043-48
12 " 3087-92
2000 acid pump 23 oil & 15 water
in 20 hrs.
- 6/9 " "
- 6/16 Lans 3016
Arb. 3270
5" @ 3271'
Perf. Lans.
2000 acid
Pump 26 pot
T.D. 3299'
Gravity 39

**ABANDONED
COMPLETED**

KANSAS

Russell

Map No. 72 Sec. 12 Twp. 14 R. 15W

Well No. 2 Mills

Eldorado Refining Company

FIRST REPORT Contractor

C SL NE SW

SECTION PLAT

990 Ft. from N. Line

_____ Ft. from S. Line

660 Ft. from E. Line

_____ Ft. from W. Line

GORHAM POOL

Location _____

Rig up _____

Drilling and Remarks:

Surface Hole

RECORD

Cased _____ in., _____ ft.

Sand _____

Gas _____

Oil _____

Total Depth _____

PRODUCTION

1st 24 hrs. Nat. _____

1st 24 hrs. after shot _____

Gas _____ Cu. Ft.

Dry Hole _____

Abandoned _____

Date

MAY 5 1943 19

S. J. LEWIS Scout

Rus sell

Map No. Sec. 12 Twp. 14 R. 15W

Well No. 2 Mills

Eldorado Refining Company

COMPLETED

Contractor

C SL NE SW

SECTION PLAT

990 Ft. from N. Line

_____ Ft. from S. Line

660 Ft. from E. Line

_____ Ft. from W. Line

GORHAM POOL

Location _____

Rig up _____

Drilling and Remarks:

Li ans 3016
Ar 43270
5" @ 271
Prof. Li ans.
2000 acid
Pump 26 Pst
290/30

RECORD

Cased _____ in., _____ ft.

Sand _____

Gas _____

Oil _____

Total Depth 2297

PRODUCTION

1st 24 hrs. Nat. _____

1st 24 hrs. after shot _____

Gas _____ Cu. Ft.

Dry Hole _____

Abandoned _____

Date

JUN 16 1943 19

S. J. LEWIS Scout