

# KANSAS

FORM 51 5M 4-41 PETROL


Russell

Section 12 Township 14 Range 15-W

Well No. 2 Boxberger "C"

Company Skelly

Hall-Gurney pool

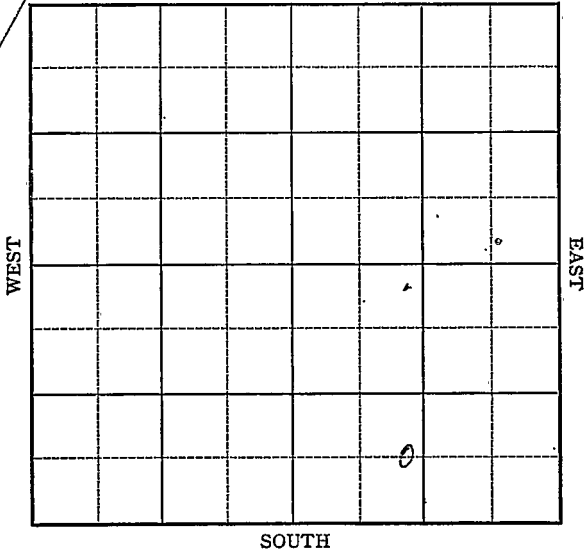

Sec. 12 Twp. 14 R. 15-W

Well No. #2 Boxberger "C" Farm

Skelly Company

(Hall-Gurney)


         Ft. from N. Line

660 Ft. from S. Line

         Ft. from E. Line

990 Ft. from W. Line

Elev. 1863

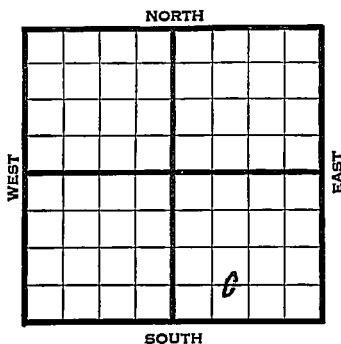

1941	REPORT
9/17	Rotary.
9/25	10" - 316' Drlg. 1941'
10/2	Dodge 2991' Lans. 3032'
	Arb. 3279-80' T.D. Run casing.
10/9	6" - 3278' Drilled cement to
	3228' 119 shots 3028-83'
	500' oil 8 hours.
10/15	Lans. 3032'
	Arb. 3279'
	6" - 3278'
	T.D. 3280'
	119 shots 3028-83' 500' bbls.
	5000 acidity
	Potential 338 bbls., pump.
	38. Gravity
	<b>COMPLETED</b>



Map No. K-72 Sec. 12 Twp. 14 R. 15W

Well No. 2 Boxberger "C"

Skelly Company

**COMPLETED** Contractor

C EL SW SE

         Ft. from N. Line

660 Ft. from S. Line

         Ft. from E. Line

990 Ft. from W. Line

SECTION PLAT


HALL GURNEY POOL

Location                                 

Rig up                                 

Drilling and Remarks:

*House 3032  
 Art 3279  
 6" @ 3278  
 119 Shuts 3028-83  
 500 acid  
 Pump 338 BX  
 380 Bu*

RECORD

Cased          in.,          ft.

Sand                                 

Gas                                 

Oil                                 

Total Depth 3280

PRODUCTION

1st 24 hrs. Nat.                         

1st 24 hrs. after shot                         

Gas                                  Cu. Ft.

Dry Hole                                 

Abandoned                                 

Date

OCT 15 1941 19

S. J. LEWIS Scout