

Company B ace Oil





10-1-43 KANSAS

Russell

Sec. 12 Twp. 14 R. 15-W

Well No. #1 Boxberger Farm


Base Oil Company

660 Ft. from N. Line

 Ft. from S. Line

990 Ft. from E. Line

990 Ft. from W. Line

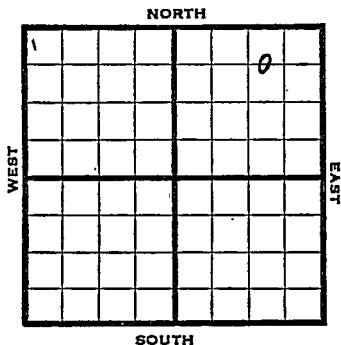

C WL NE NE

1945 Elev. 1864' REPORT

9/26 10" @ 280'
Anhy. 680'
Drlg. 2810'

10/3 " "

10/10 Topeka 2715
TD 2940
7" @ 2931 RUST

10/17 500 acid.
1/4 oil plus 3-3/4 WPH

10/24 Drlg. 3234

10/31 Arb. 3288
TD 3288
457' of 4" liner @ 3288 WOC

11/7 TD 3293
700' oil drilling up some iron in the
hole

11/14 TD 3295
800' oil

11/21 3288 Gotham corrected no Arb.
TD 3295'

11/28 " " " "

12/5 " " " "

12/12 " " " "

12/20 " " " "

12/29 " " " "

OVER

1946

1/9

Gorham 3288

7" @ 2931

457' of 4" liner

TD 3295'

Pump 34 Pot1

Grav. 37.0

COMPLETED

KANSAS

Kansas

Pool Name Big CreekMap No. 72 Sec. 12 Twp. 14 R. 15WWell No. 1 Boxberger


Bace Oil

Company

FIRST REPORT

Contractor

C WL NE NE

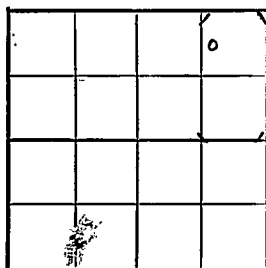SECTION PLAT660 Ft. from N. Line Ft. from S. Line990 Ft. from E. Line Ft. from W. Line ✓Russell CountyLocation Rig up 9/13

Drilling and Remarks:

10"-280
anhy 680

2810

RECORDCased in., ft.Sand Gas Oil Total Depth **PRODUCTION**1st 24 hrs. Nat. 1st 24 hrs. after shot Gas Cu. Ft.Dry Hole Abandoned

Date

SEP 26 1945

19

S. J. FWIS

Scout

KANSAS Kansas Pool Name Big Creek
 Map No. 72 Sec. 12 Twp. 14 R. 15W
 Well No. 1 Boxberger

Bace Oil

Company

COMPLETED

Contractor

C WL NE NE

E 1/8 64

SECTION PLAT

660 Ft. from N. Line

Ft. from S. Line

990 Ft. from E. Line

Ft. from W. Line

Russell County

			o

Location

Rig up

Drilling and Remarks:

Gr. kavu 3288
7' 0 2931
457 1/4" line
Pump 34 P.D.

32° 9'

RECORD

Cased in., ft.

Sand

Gas

Oil

Total Depth *1225*

PRODUCTION

1st 24 hrs. Nat.

1st 24 hrs. after shot

Gas Cu. Ft.

Dry Hole

Abandoned

Date

JAN 9 1946 19 S. J. LEWIS Scout