

Russell

FORM 51 25M 3-49 PETROL


**KANSAS**  
Township **15S**

Section **12** Range **15W**

Well No. **#2 Steinert**

Company **B & R Drlg.**

NORTH

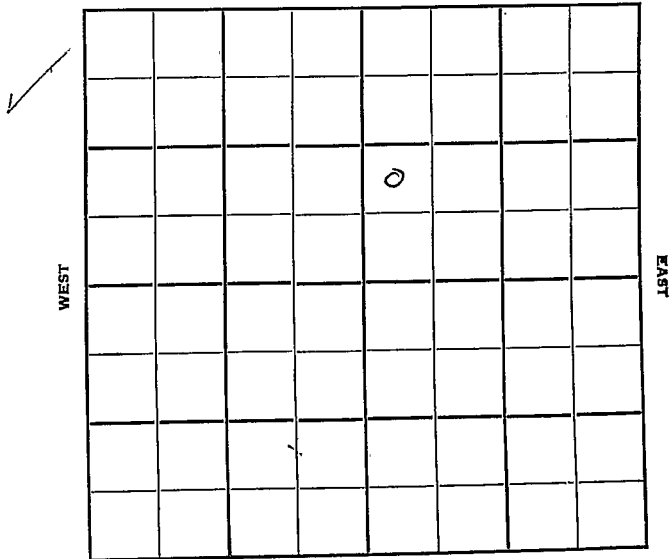

SOUTH

WEST

EAST



Sec. 12 Twp. 14 R. 15-W

Well No. #2 Steinert Farm

B & R Drlg Company


Cont. B & R Drlg

Gorham Pool  
Ft. from N. Line

990 Ft. from S. Line

\_\_\_\_\_ Ft. from E. Line

330 Ft. from W. Line

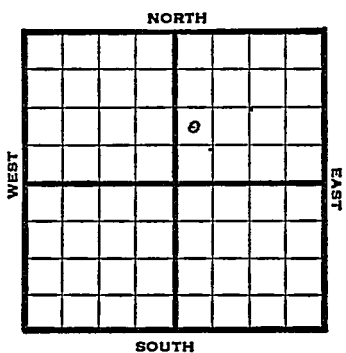

NW SW NE

1949 Elev. 1860' REPORT

10/5 8" @ 610'  
Anhy 889  
Drlg 1763'

10/12 Lansing 3028'  
Drlg 3278'

10/19 Arb 3273-  
5 @ 3273'  
TD 3277'  
500 acid  
Swb 1 Oil / 18W PH  
PB

10/26 "  
11/1 "  
11/9 "  
11/16 "  
11/23 "  
11/30 TD 3277'  
Lansing 3019'  
Arb. 3273'  
5" @ 3273'  
Perf Lans  
500 acid  
Pump 35 Oil Pot  
38° Gr.  
Comp

**COMPLETED**

Kansas

Map No. \_\_\_\_\_ Sec. 12 Twp. 14 R. 15W

Well No. 2 Steinert

B &amp; R Drlg. \_\_\_\_\_ Company

B &amp; R Drlg. \_\_\_\_\_ Contractor

NW SW NE

FIRST REPORT  
SECTION PLAT

		o	

\_\_\_\_\_ Ft. from N. Line

990 \_\_\_\_\_ Ft. from S. Line

\_\_\_\_\_ Ft. from E. Line

330 \_\_\_\_\_ Ft. from W. Line

Russell County

Location \_\_\_\_\_

Rig up \_\_\_\_\_

Drilling and Remarks:

8" @ 610

Anhy 889

drlg. 1763

## RECORD

Cased \_\_\_\_\_ in., \_\_\_\_\_ ft.

Sand \_\_\_\_\_

Gas \_\_\_\_\_

Oil \_\_\_\_\_

Total Depth \_\_\_\_\_

## PRODUCTION

1st 24 hrs. Nat. \_\_\_\_\_

1st 24 hrs. after shot \_\_\_\_\_

Gas \_\_\_\_\_ Cu. Ft.

Dry Hole \_\_\_\_\_

Abandoned \_\_\_\_\_

Date

OCT 5 1949 19

S. J. LEWIS Scout

Map No. \_\_\_\_\_ Sec. 12 Twp. 14 R. 15W

Well No. 2 Steinert

B & R Drlg. \_\_\_\_\_ Company

COMPLETE

Contractor

NW SW NE

*E. 1868*

SECTION PLAT

\_\_\_\_\_ Ft. from N. Line

990 Ft. from S. Line

\_\_\_\_\_ Ft. from E. Line

330 Ft. from W. Line

		o	

Russell County

Location \_\_\_\_\_

Rig up \_\_\_\_\_

Drilling and Remarks:

*Lane 0019*

*Cr 3273*

*5" @ 3273*

*Prof Lane  
Booace*

*Pump 35 in Oil  
382 lb*

RECORD

Cased \_\_\_\_\_ in., \_\_\_\_\_ ft.

Sand \_\_\_\_\_

Gas \_\_\_\_\_

Oil \_\_\_\_\_

Total Depth *3273*

PRODUCTION

1st 24 hrs. Nat. \_\_\_\_\_

1st 24 hrs. after shot \_\_\_\_\_

Gas \_\_\_\_\_ Cu. Ft.

Dry Hole \_\_\_\_\_

Abandoned \_\_\_\_\_

Date

NOV 30 1949

19

S. J. LEWIS

Scout