


KANSAS

Section 12 Township 14 Range 15WWell No. #1 BoxbergerCompany Davis Childs

NORTH

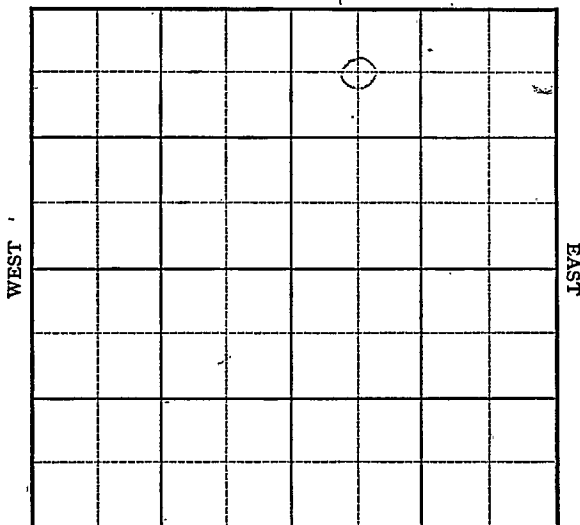

SOUTH



KANSAS

Russell County

Sec. 12 Twp. 14 R. 15W

Well No. #1 Boxberger Farm
Davis Childs Company

Big Creek

NORTH

660 Ft. from N. Line


_____ Ft. from S. Line

_____ Ft. from E. Line

660 Ft. from W. Line

C NW NE

Elmer 1866

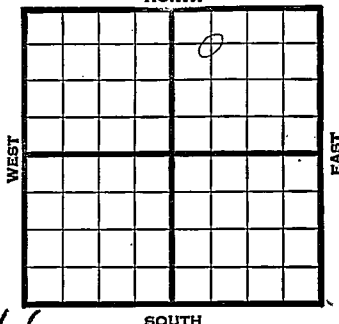

1945

REPORT

3/28	SH	
4/5	Ank	880
	8-5/8" @ 894	
	Drlg. 2365	
4/12	Lans	3031
	Arb	3292
	Gorham	3295-97 TD
	Run 5"	
4/20	5" @ 3292'	RUST
4/27	600' fluid 6 hrs.	C.O.
5/3	" " " " "	
5/10	" " " " "	
5/17	" " " " "	
5/23	Reagan	3293
	5" @ 3292	
	TD 3296	
	Pump 83 Pot.	
	Grav. 37.0	

COMPLETED

Pool Name Big CreekMap No. 72 Sec. 12 Twp. 14 R. 15 WWell No. 1 BoxbergerDavis Childs

Company

FIRST REPORT

Contractor

C NW NE

SECTION PLAT

660 Ft. from N. Line Ft. from S. Line Ft. from E. Line660 Ft. from W. Line

✕		o	

RussellLocation Rig up

Drilling and Remarks:

SH

RECORD

Cased in., ft.Sand Gas Oil Total Depth

PRODUCTION

1st 24 hrs. Nat. 1st 24 hrs. after shot Gas Cu. Ft.Dry Hole Abandoned

Date

MAR 28 1945 19 S. J. LEWIS

Scout

Pool Name Big CreekMap No. 72 Sec. 12 Twp. 14 R. 15WWell No. 1 BoxbergerDavis-Childs

Company

CORRECTION

Contractor

C NW NE

SECTION PLAT

660 Ft. from N. Line Ft. from S. Line Ft. from E. Line660 Ft. from W. Line

		o	

RussellLocation Rig up

Drilling and Remarks:

had spotted
wrong

RECORD

Cased in., ft.Sand Gas Oil Total Depth

PRODUCTION

1st 24 hrs. Nat. 1st 24 hrs. after shot Gas Cu. Ft.Dry Hole Abandoned

Date

MAR 28 1945

19

S. J. LEWIS

Scout

Kans Pool Name Big CreekMap No. 72 Sec. 12 Twp. 14 R. 15WWell No. 1 BoxbergerDavis-Childs CompanyCOMPLETED

Contractor

C NW NE

E 1/8 66
SECTION PLAT660 Ft. from N. Line Ft. from S. Line Ft. from E. Line660 Ft. from W. Line

		0	

Russell CountyLocation Rig up

Drilling and Remarks:

Reagan 3292
5" @ 3292Pump 300 ft37-4-88

RECORD

Cased in., ft.Sand Gas Oil Total Depth 3296

PRODUCTION

1st 24 hrs. Nat. 1st 24 hrs. after shot Gas Cu. Ft.Dry Hole Abandoned

Date

MAY 23 1945

19

S. J. LEWIS

Scout