

# KANSAS


Russell

Section 12 Township 14 Range 15 W.


Well No. I Steinert

Company B & R Drlg.

Gorham  
NORTH

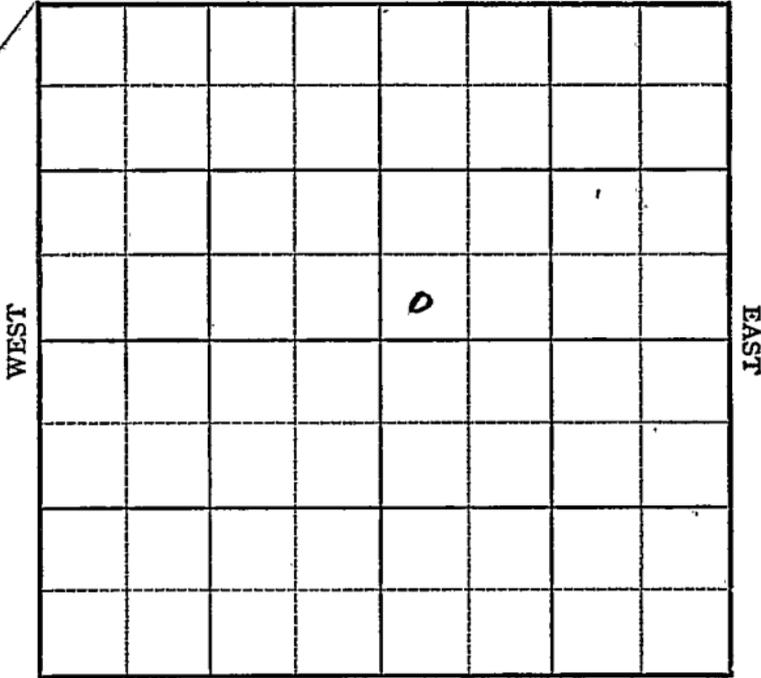

SOUTH

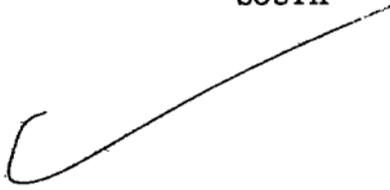

Sec. 12 Twp. 14 R. 15W

Well No. 1 Steinert Farm \_\_\_\_\_

B & R Drlg. Company \_\_\_\_\_

Gorham

B & R Drlg. Contr NORTH


\_\_\_\_\_ Ft. from N. Line

330 Ft. from S. Line

\_\_\_\_\_ Ft. from E. Line

330 Ft. from W. Line

SW NE

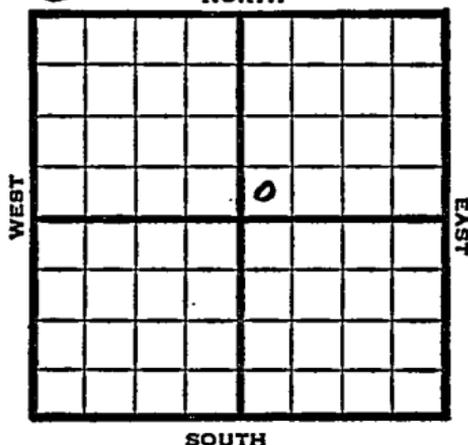

1949 Elev 1837' REPORT

7/27 8" @ 590  
Anhy 878  
Lans 3015  
3140  
8/3 "  
8/10 Arb. 3280-83'  
TD 3283'  
5" @ 3281'  
Plug 3090-  
24 shots 3054-58  
24 shots 3058-60  
swb 4 bbls oil PH  
8/17 "  
8/24 "  
8/31 "  
9/7 "  
9/14 TD 3283'  
Arb. 3280'  
5" @ 3281'  
Lans 3015'  
Perf Lans  
Pump 50 Oil Pot  
38° Gr.  
Comp

**COMPLETED**

Map No. \_\_\_\_\_ Sec. 12 Twp. 14 R. 15W

Well No. 1 Steinert

B & R Drlg. \_\_\_\_\_ Company

B & R Drlg. \_\_\_\_\_ Contractor

SW NE

FIRST REPORT  
SECTION PLAT

\_\_\_\_\_ Ft. from N. Line

330 Ft. from S. Line

\_\_\_\_\_ Ft. from E. Line

330 Ft. from W. Line


Russell County

Location \_\_\_\_\_

Rig up \_\_\_\_\_

Drilling and Remarks:

8" @ 590

anhy 878

Lans 3015

3140

RECORD

Cased \_\_\_\_\_ in., \_\_\_\_\_ ft.

Sand \_\_\_\_\_

Gas \_\_\_\_\_

Oil \_\_\_\_\_

Total Depth \_\_\_\_\_

PRODUCTION

1st 24 hrs. Nat. \_\_\_\_\_

1st 24 hrs. after shot \_\_\_\_\_

Gas \_\_\_\_\_ Cu. Ft.

Dry Hole \_\_\_\_\_

Abandoned \_\_\_\_\_

Date

JUL 27 1949 19

S. J. LEWIS

Scout

