


Give All Information Completely  
Make Required Affidavit  
Mail or Deliver Report to:  
Conservation Division  
State Corporation Commission  
211 No. Broadway  
Wichita, Kansas

## WELL PLUGGING RECORD

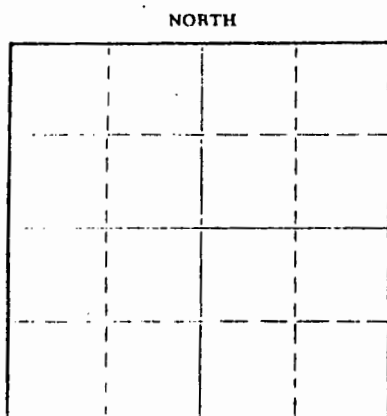

Locate well correctly on above  
Section Plat

Russell County, Sec. 27 Twp. 14 Rge. 13 (E) W (W)  
Location as "NE/CNW/SW" or footage from lines SW/4 NW/4 NW/4  
Lease Owner Shields Oil Producers, Inc.  
Lease Name Rein Well No. 1  
Office Address Russell, Kansas  
Character of Well (completed as Oil, Gas or Dry Hole) Dry hole  
Date well completed June 19 19 64  
Application for plugging filed June 20 19 64  
Application for plugging approved June 22 19 64  
Plugging commenced July 17 19 64  
Plugging completed July 21 19 64  
Reason for abandonment of well or producing formation

If a producing well is abandoned, date of last production 19  
Was permission obtained from the Conservation Division or its agents before plugging was commenced? Yes

Name of Conservation Agent who supervised plugging of this well Truan  
Producing formation Depth to top Bottom Total Depth of Well 3204 Feet  
Show depth and thickness of all water, oil and gas formations.

## OIL, GAS OR WATER RECORDS

## CASING RECORD

| FORMATION | CONTENT | FROM | TO | SIZE   | PUT IN | PULLED OUT     |
|-----------|---------|------|----|--------|--------|----------------|
|           |         |      |    | 8 5/8" | 260'   | Cmtd w/200 sax |
|           |         |      |    | 4 1/2" | 2406'  | 1,733'         |
|           |         |      |    |        |        |                |
|           |         |      |    |        |        |                |
Describe in detail the manner in which the well was plugged, indicating where the mud fluid was placed and the method or methods used in introducing it into the hole. If cement or other plugs were used, state the character of same and depth placed, from 3204 feet to surface feet for each plug set.

Fill w/sand to 2,260', dump 4 sax cement on sand.  
Fill w/heavy mud to 260'  
Set bridge plug @260', dump 9 sax cement on bridge plug  
Run 70 sax cement thru 6 jts 2" tubing to cellar

RECEIVED  
STATE CORPORATION COMMISSION

AUG 12 1964

CONSERVATION DIVISION  
Wichita, Kansas

(If additional description is necessary, use BACK of this sheet)  
Name of Plugging Contractor Barnes & Sons Pipe pulling Company  
Address P. O. Box 313, Russell, Kansas

STATE OF Kansas COUNTY OF Russell ss.

R. L. Shields (employee of owner) or (owner or operator) of the above-described well, being first duly sworn on oath, says: That I have knowledge of the facts, statements, and matters herein contained and the log of the above-described well as filed and that the same are true and correct. So help me God.

(Signature)

R. L. Shields

Shields Building, Russell, Kansas  
(Address)

SUBSCRIBED AND SWORN TO before me this 11th day of August, 1964

My commission expires

January 31, 1968

Agnes M. Appel

Notary Public.