

25-14-13W

TYPE

AFFIDAVIT OF COMPLETION FORM

ACO-1 WELL HISTORY

Compt. \_\_\_\_\_

SIDE ONE

(Rules 82-3-130 and 82-3-107)

DOCKET NO. NP \_\_\_\_\_

This form shall be filed with the Kansas Corporation Commission, 200 Colorado Derby Building, Wichita, Kansas 67202, within ninety (90) days after the completion of a well, regardless of how the well was completed.

State Geological Survey  
WICHITA BRANCH

FOR INFORMATION REGARDING THE NUMBER OF COPIES TO BE FILED AND APPLICATIONS REQUIRING COPIES OF ACO-1 FORMS SEE PAGE TWO (2), SIDE TWO (2) OF THIS FORM.

F \_\_\_\_\_ Letter requesting confidentiality attached.

C  Attach ONE COPY of EACH wireline log run (i.e. electrical log, sonic log, gamma ray neutron log etc.)\*\*\*Check here if NO logs were run \_\_\_\_\_.

PLEASE FILL IN ALL INFORMATION. IF NOT AVAILABLE, INDICATE. IF INFORMATION LATER BECOMES AVAILABLE, SUBMIT BY LETTER.

LICENSE # 8399 EXPIRATION DATE 3/84

OPERATOR Great Bend Oil Producers API NO. 15-167-22,248

ADDRESS Box 1054 COUNTY Russell

Great Bend, Kansas 67530 FIELD \_\_\_\_\_

\*\* CONTACT PERSON Garey Pennington PROD. FORMATION \_\_\_\_\_  
PHONE 316-792-3923 \_\_\_\_\_ Indicate if new pay.

PURCHASER na LEASE Langhofer

ADDRESS \_\_\_\_\_ WELL NO. 1

WELL LOCATION NW SE NW

DRILLING Allen Drilling Company 1890 Ft. from south Line and

CONTRACTOR Box 1389 1655 Ft. from east Line of

ADDRESS Great Bend, Kansas 67530 the NW (Qtr.) SEC 25 TWP 14 RGE 13 (W).

PLUGGING Allen Drilling Company

CONTRACTOR Box 1389

ADDRESS Great Bend, Kansas 67530

TOTAL DEPTH 2375' PBDT \_\_\_\_\_

SPUD DATE 11-8-83 DATE COMPLETED 11-11-83

ELEV: GR 1681' DF 1683' KB 1686'


DRILLED WITH (~~CABLE~~) (~~ROTARY~~) (~~AIR~~) TOOLS.

DOCKET NO. OF DISPOSAL OR REPRESSURING WELL BEING USED TO DISPOSE OF WATER FROM THIS LEASE \_\_\_\_\_.

Amount of surface pipe set and cemented 638' DV Tool Used? \_\_\_\_\_.

TYPE OF COMPLETION THIS AFFIDAVIT APPLIES TO: (Circle ONE) - Oil, Shut-in Gas, Gas, Dry, Disposal, Injection, Temporarily Abandoned. If OWWO, indicate type of re-completion \_\_\_\_\_. Other completion \_\_\_\_\_. NGPA filing \_\_\_\_\_.

WELL PLAT

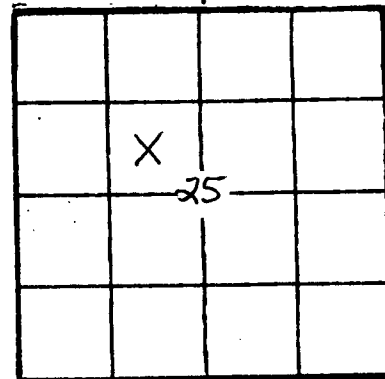

(Office Use Only)

KCC \_\_\_\_\_  
KGS

SWD/REP \_\_\_\_\_  
PLG. \_\_\_\_\_

NGPA \_\_\_\_\_

ALL REQUIREMENTS OF THE STATUTES, RULES AND REGULATIONS PROMULGATED TO REGULATE THE OIL AND GAS INDUSTRY HAVE BEEN FULLY COMPLIED WITH.

A F F I D A V I T

Garey Pennington, being of lawful age, hereby certifies that:

I am the Affiant, and I am familiar with the contents of the foregoing Affidavit,

Side TWO

OPERATOR Great Bend Oil Producers LEASE NAME Langhofer SEC 25 TWP 14 RGE 13

WELL NO 1

FILL IN WELL INFORMATION AS REQUIRED:

Show all important zones of porosity and contents thereof; cored intervals, and all drill-stem tests, including depth interval tested, cushion used, time tool open, flowing and shut-in pressures, and recoveries.

Show Geological markers, logs run, or other Descriptive information.

State Geological Survey  
WICHITA BRANCH

Formation description, contents, etc.	Top	Bottom	Name	Depth
---------------------------------------	-----	--------	------	-------

Check if no Drill Stem Tests Run.  
Check if samples sent Geological Survey.

Anhydrite	629	(+1061)		
Grand Haven Lime	2194	(- 504)		
1st Tarkio Sand	2207	(- 517)		
Dover Lime	2221	(- 531)		
2nd Tarkio Sand	2228	(- 538)		
Tarkio Lime	2267	(- 577)		
Elmont Lime	2323	(- 633)		
R.T.D.	2335	(- 645)		
L.T.D.	2335	(- 645)		

D.S.T. #1 2196-2235

Open 60 min (30-30-30-30)  
Recover: 120' gas, 180' muddy water with few oil spots.  
30" ISIP: 161 psi. 30" FSIP: 183 psi.  
30" IFP: 75-86 psi 30" FFP: 118-129 psi. temp 100

If additional space is needed use Page 2

Report of all strings set — surface, intermediate, production, etc. **CASING RECORD (New) or (Used)**

Purpose of string	Size hole drilled	Size casing set (in O.D.)	Weight lbs/ft.	Setting depth	Type cement	Secks	Type and percent additives
Surface	12-1/4"	8-5/8"	23#	645'	60/40 Poz		2% Gel, 3% CC

**LINER RECORD**

**PERFORATION RECORD**

Top, ft.	Bottom, ft.	Secks cement	Shots per ft.	Size & type	Depth interval

**TUBING RECORD**

Size	Setting depth	Pecker set at