


DX 78-1 WALLACE

KANSAS

Section 13 Township 14 Range 42W

Well No. 1 Fitzgerald

Company United Producing

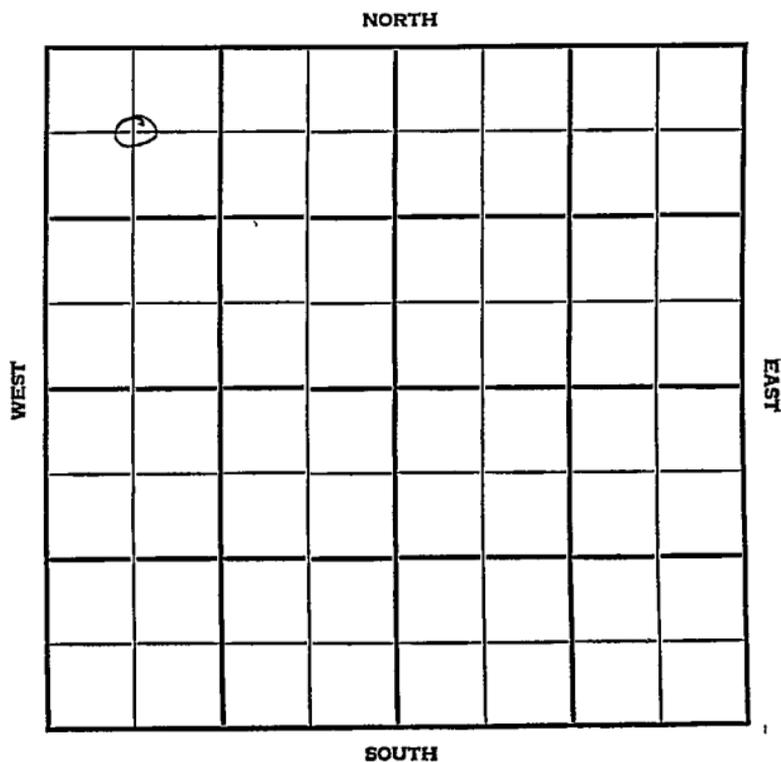

## Wallace

KANSAS

|      |      |     |
|------|------|-----|
| SEC. | TWP. | R.  |
| 13   | 14   | 42W |

WELL NO.

#1 Fitzgerald

FARM

COMPANY

United Producing

CONTRACTOR

Parker

Wildcat.

| |
|---|
| 660   | Ft. from N. Line | <table border="1"> <tr><td colspan="6">NORTH</td></tr> <tr><td>0</td><td></td><td></td><td></td><td></td><td></td></tr> <tr><td></td><td></td><td></td><td></td><td></td><td></td></tr> <tr><td></td><td></td><td></td><td></td><td></td><td></td></tr> <tr><td></td><td></td><td></td><td></td><td></td><td></td></tr> <tr><td></td><td></td><td></td><td></td><td></td><td></td></tr> <tr><td colspan="6">SOUTH</td></tr> </table> | NORTH |  |  |  |  |  | 0 |  |  |  |  |  |  |  |  |  |  |  |  |  |  |  |  |  |  |  |  |  |  |  |  |  |  |  |  |  | SOUTH |  |  |  |  |  |
| NORTH | |
| 0     | |
| |
| |
| |
| |
| SOUTH | |
|       | Ft. from S. Line | |
|       | Ft. from E. Line | |
| 660   | Ft. from W. Line | |

C NW NW

|      |           |        |
|------|-----------|--------|
| 1955 | ELEVATION | REPORT |
|      | 3799'     |        |

3/30

MI R

6/1

Comm 4-3-55

H. Wreford 3380 TD 5350

Logs: Anh Coungr 3426, Tp Adm  
3748, Tr. Waub 3915, Dg Top 4068,  
L. Morr 4988, Ce 4724, M 5142,  
TD 5350

13" @ 500/500 8 5/8" @ 3112/500

DST 5210-5350 open 45 min. Rec 105'

mud 415/20" DST 3575-3616 failed

DST 3575-2616 open 10 min. failed

DST 3565-3606 failed DST 3571-3611  
failed

D &amp; A

**ABANDONED**

County Wallace Elev. 3799

Sec. 13 Twp. 14 Rge. 42W

Company United Prod.

FarmName Fitzgerald No. 1

| TOPS               | DEPTH       | LOG         | DATUM       |
|--------------------|-------------|-------------|-------------|
| Anh. <u>Cougar</u> |             | <u>3426</u> | <u>-373</u> |
| Tp. <u>Adm</u>     |             | <u>3748</u> | <u>+51</u>  |
| H. <u>Wreford</u>  | <u>3380</u> |             |             |
| Tr. <u>Waub</u>    |             | <u>3915</u> | <u>116</u>  |
| Dg. <u>Top</u>     |             | <u>4068</u> | <u>269</u>  |
| Bl.                |             |             |             |
| L. <u>Morr</u>     |             | <u>4988</u> | <u>1189</u> |
| K.C.               |             |             |             |
| B.K.C.             |             |             |             |
| Ce.                |             | <u>4724</u> | <u>925</u>  |
| C.                 |             |             |             |
| M.                 |             | <u>5142</u> | <u>1343</u> |
| M.                 |             |             |             |
| K.                 |             |             |             |
| Mz.                |             |             |             |
| Me.                |             |             |             |
| V.                 |             |             |             |
| S.                 |             |             |             |
| S.                 |             |             |             |
| A                  |             |             |             |
| R.                 |             |             |             |
| Pe.                |             |             |             |
| G.                 |             |             |             |
| TD.                | <u>5350</u> | <u>5350</u> |             |

Loc. in Sec. C NW NW

Geol.

Contr.

Parker

Pool

Wildcat

|   |  |  |
|---|--|--|
| 0 |  |  |
|   |  |  |
|   |  |  |

**ABANDONED**

Date Comm. 4-3-55 JUN. 1 1955

13" @ 500/500 8 5/8" @ 3112/500

DST 5210-5350 open 45 min. Rec. 105' mud

415/20" DST 3575-3616 failed

DST 3575-3616 open 10 min. failed

DST 3565-3606 failed DST 3571-3611

failed

D & A

Co.

Lse.

No.

Sec.

T.

R.

County Wallace State Kansas

Sec. 13 (Blk.) 14 (Sur.) 42W Map No.

Operator United Producing

Well No. 1 Farm Fitzgerald

Elev. \_\_\_\_\_ Location C NW NW

|   |  |  |  |  |  |
|---|--|--|--|--|--|
| ⊙ |  |  |  |  |  |
|   |  |  |  |  |  |
|   |  |  |  |  |  |
660 Ft. From N Line NW

660 Ft. From W Line Quarter

Ist. Report MAR 30 1955

Completion \_\_\_\_\_

Remarks \_\_\_\_\_

Parker - Contr.

Spudding Date \_\_\_\_\_

Drlg. Data Wildcat

M I R

FABEN GILSTRAP