


Section 13 Township 14 Range 28W


Well No. #1 Herfner

Company C. E. Skiles et al

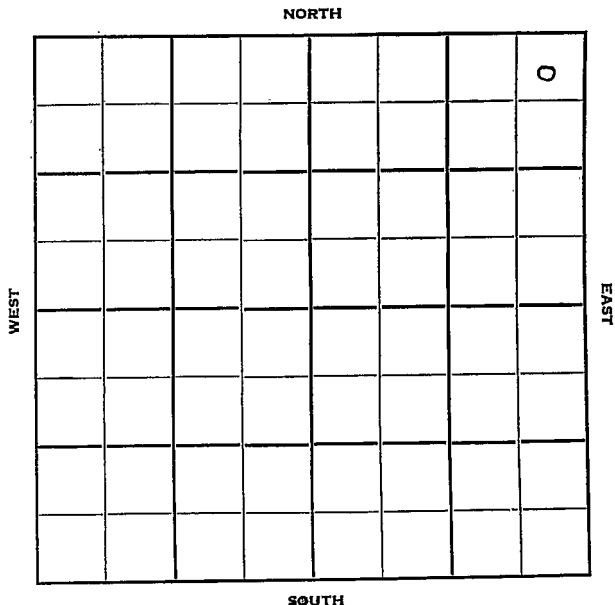

Sec. 13 Twp. 14 R. 28WWell No. #1 Herfner FarmC. E. Skiles et al CompanyWildcat Contractor330 Ft. from N. Line Ft. from S. Line330 Ft. from E. Line Ft. from W. Line

NE NE NE

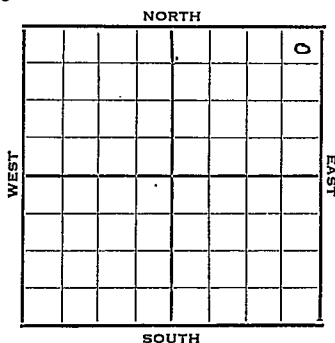

1952 Elev. 2531' REPORT

5/21 Location

5/28 "

6/11 10" @ 164'

Drilling

6/18 TD 3075 lost fish Skid rig

6/25 Anhy 1500' 10" @ 160' Heeb 3693'
Fishing for drill collar 3705'.7/2 Lans. 3737 DST 3858-65 37 min
8' M 695# Marm 4038
Drlg. 4330'7/9 Spud 5-31-52
D & A TD 4469' 10" @ 164
Twist off @ 2870 Skid rig 30' west
10" @ 160 Anhy 1500' Heeb 3696'
Lans. 3737'
DST 3858-65 open 37 mins, rec 8' mud
Marm 4038'
DST 3869-96 open 1 hr. rec 423' SW
940# TD 4469' Miss 4317'
D & A**ABANDONED**

County Gove State Kansas
 Sec. 13 (Blk.) 14 (Sur.) 28W Map No.
 Operator C. E. Skiles et al.
 Well No. 1 Farm Herfner
 Elev. 2531 Location NE NE NE

						0

330 Ft. From N Line NE330 Ft. From E Line Quarter

1st. Report

Completion JUL 9 1952Remarks WildcatSpudding Date 5-31-52Drlg. Data D & A TD 446910" @ 164 5' Twist off @ 2870 Skid rig30' west 10" @ 160 Anhy 1500Heeb. 3696 Lans. 3737 DST 3858-65open 37 min. Rec. 8' mud Marm. 4038DST 3969-96 open 1 hr. Rec. 423' sw940# TD 4469 Miss. 4317D & A