

Russell

KANSAS

SECTION 13 TOWNSHIP 14 RANGE 15 W


WELL NO. #7 Holland "B"

COMPANY Chet Loving et al


NORTH

WEST

EAST

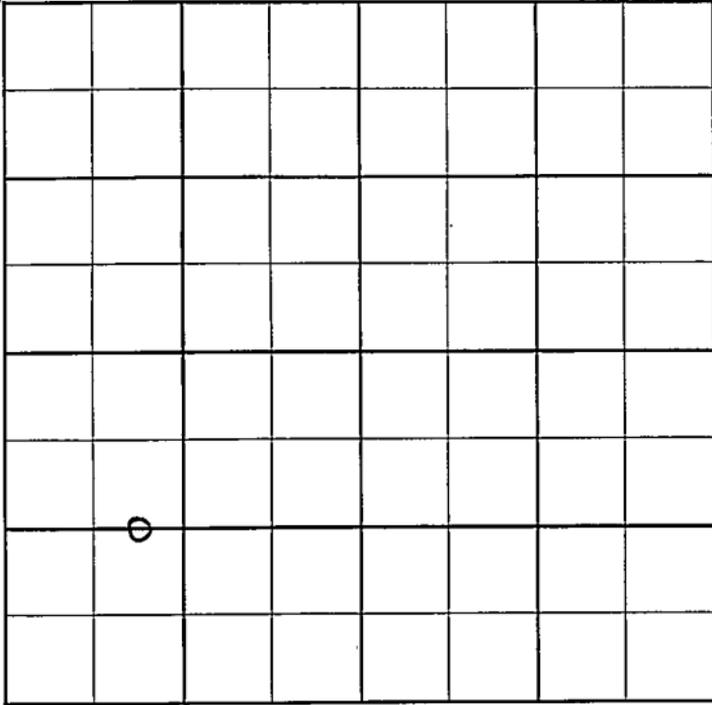

SOUTH

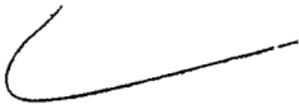

Russell

KANSAS

SEC.	TWP.	R.
13	14	15W

WELL NO.

#7 Holland "B"

FARM

COMPANY

Chet Loving et al

CONTRACTOR

Duke


Gorham

_____ Ft. from N. Line

_____ Ft. from S. Line

_____ Ft. from E. Line

_____ Ft. from W. Line

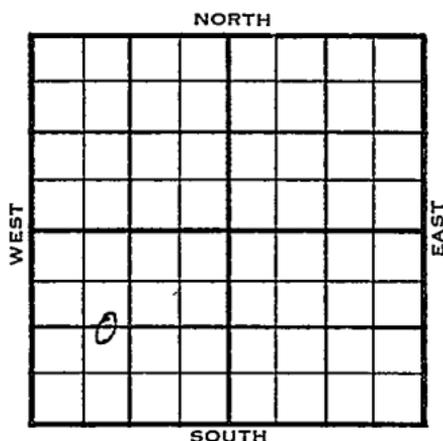E $\frac{1}{2}$ W $\frac{1}{2}$ SW

	ELEVATION	REPORT
1955	1843'	
10/26	Comm 10-24-55	
12-7	8 5/8" @ 880/400	
	5 1/2" @ 3254/100	
	CO to 3255, 20 A, 250 A, FU 2600' oil	
	12 hr.,	
	P/ 60 bopd	
	Comp. 25 bopd	
	Anh. 877	
	Tp. 2737	
	H. 2961	
	KC 3014	
	A. 3250	
	TD 3255'	
		COMPLETED

County Russell Elev. _____
 Sec. 13 Twp. 24 Rge. 15W
 Company Chet Loving et al.
 Farm Name Holland "B" No. 7

TOPS	DEPTH	LOG	DATUM
Anh.			
Tp.			
H.			
Tr.			
Dg.			
Bl.			
L.			
K.C.			
B.K.C.			
Ce.			
C.			
M.			
M.			
K.			
Mz.			
Ma.			
V.			
S.			
S.			
A.			
R.			
PE.			
G.			
T.D.			

Loc. in Sec. E $\frac{1}{2}$ W $\frac{1}{2}$ SW
 Geol. _____
 Contr. Duke
 Pool Gorham

FIRST REPORT
 OCT 25 '55

Date Comm. 10-24-55

Co.
 Lse.
 No.
 Sec.
 T.
 R.

B

County Russell Elev. 1843
 Sec. 18 Twp. NI Rge. 1 5W
 Company Chet Loving et al.
 Farm Name Holland "B" No. 7

TOPS	DEPTH	LOG	DATUM	Loc. in Sec.
Anh.	877			E $\frac{1}{2}$ W $\frac{1}{2}$ SW
T.P.	2737		894	
H.	2961		1118	
Tr.				
Dg.				
Bl.				
L.				
K.C.	3014		1171	Geol. _____
B.K.C.				Contr. _____
Ce.				Duke
C.				
M.				Pool _____
M.				Gorham
K.				
Mz.				
Mq.				
V.				
S.				
S.				COMPLETED
A.	3250		1407	
R.				
PE.				
G.				
T.D.	3255			

Date Comm. 10-24-55 DEC 7 1955

8 5/8" @ 880/100 5 1/2" @ 3254/100

CO to 3255 20 A 250 A FU 2600' oil

12 hr. P/ 60 bopd Comp. 25 bopd